December 19, 2018

BY RESS

Ms. Kirsten Walli
Board Secretary
Ontario Energy Board
2300 Yonge Street, 27th Floor
Toronto, ON M4P 1E4

Dear Ms. Walli:

RE: Union Gas Limited ("Union")
Kingsville Transmission Reinforcement Project
EB-2018-0013

Please find attached Change Request 1, for the above-noted project.

Union believes that these changes are not significant and would appreciate your timely review and approval of this request.

In the event that you have any questions or would like to discuss in more detail, please do not hesitate to contact me at 519-436-4601.

Sincerely,

[original signed by]

Mark A. Murray J.D.
Manager, Regulatory Projects & Land Acquisition

cc: Zora Crnojacki, OEB

REQUEST TO VARY

Project Name: Kingsville Reinforcement Project

OEB File Number: EB-2018-0013

Change Request: 1

Description and Rationale for Change

Union is proposing changes to the dimensions and locations of temporary land use areas ("Land Rights") at various locations along the pipeline route to facilitate pipeline construction.

Construction and Restoration Practices

There are no changes proposed for the construction of the proposed facilities.

Environmental

No new environmental mitigation measures will be required.

Consultation

Union has met with the directly affected landowners with respect to the Land Rights and no issues have been identified.

Lands

Union has acquired the necessary Land Rights from the landowners.

Costs

These changes will not result in an increase to the project budget.

Schedule

These changes will not result in any change to the project in-services date.

Maps

A chart setting out the changes in land rights, which are identified in red is attached at Schedule 1.

Maps showing the location of the Land Rights which are identified as red cross-hatched areas are attached at Schedule 2. The top half of each individual map identifies the land rights previously included in Union's application, as Tab 13 Schedule 1, and the bottom half of each map identifies the additional Land Rights requested.

Parcel	File #	PIN		NAME & ADDRESS	PROPERTY DESCRIPTION	Dimensions (Metres) Area W	x	L	Hectares	Dimensions (Metres) Area W	x	L	Hectares	LIEN/LEASE &/OR ENCUMBRANCES
1	K1	75023-0287	LT	[redacted]	PT LT 2 CON SMR, ROCHESTER, DESIGNATED AS PTS 1, 6, 7, 12R23657; LAKESHORE S/T EASE OVER PT 6 ON 12R23657 AS IN R538952	20	x	494	0.937	8	x	470	0.376	[redacted]
						75	x	75	0.562 fee	8	x	468	0.376	
										~~23~~	~~x~~	~~100~~	~~0.23~~	
										13	x	100	0.13	
										80	x	300	2.271	
19	***County Road 8***													
20	K18	75154-0067	LT	[redacted]	PT LT 15 CON 11 GOSFIELD AS IN R574067; KINGSVILLE	20	X	574	1.149	~~8~~	~~X~~	~~574~~	~~0.457~~	[redacted]
				[redacted]						20	x	574	1.148	
										~~20~~	~~X~~	~~80~~	~~0.16~~	
										30	X	160	0.48	
25	***Road 10***													
26	K22	75155-0079	LT	[redacted]	PT LT 15 CON 9 GOSFIELD PT 2 12R6598; KINGSVILLE	20	x	678	1.358	8	x	678	0.541	[redacted]
				[redacted]						~~49~~	~~x~~	~~166~~	~~0.589~~	
										49	x	166	0.553	
										28	x	80	0.18	
31	***Road 9 East***													
32	K27	75155-0090	LT	[redacted]	PT LT 15 CON 8 GOSFIELD AS IN R256795 E OF PT 12 TO 16 12R770; T/W R579272; KINGSVILLE	20	x	221	0.442	8	x	221	0.166	[redacted]
				[redacted]						20	x	221	0.441	
										26	x	75	0.195	
										20	x	48	0.096	
40	***North Talbot Road***													
51	***Inman Sideroad***													
52	K42	75149-0190	LT	[redacted]	PT N1/2 LT 263 CON STR GOSFIELD PT 3, 4, 5, 6, 7, 8, 9 & 10 12R19722; EXCEPT PTS 1-7 12R26336; S/T R1504910; S/T R553470; KINGSVILLE	20	x	425	0.85	8	x	425	0.34	[redacted]
				[redacted]						~~20~~	~~x~~	~~100~~	~~0.09~~	
										80	x	80	0.452	
54	K44	75149-0105	LT	[redacted]	PT LT 262 CON STR GOSFIELD AS IN GS17910 EXCEPT R884237 & PTS 11 &12 RD200; KINGSVILLE	20	x	60	0.12	~~8~~	~~x~~	~~40~~	~~0.032~~	[redacted]
				[redacted]						~~70~~	~~x~~	~~90~~	~~0.591~~	
										130	x	155	1.887	
55	***Highway 3***													
56	K45	75149-0172	LT	[redacted]	PT LT 262, CON STR GOSFIELD DESIGNATED AS PT 2, PL 12R3694; EXCEPT PTS 1 TO 9 ON PL 12R17923; EXCEPT PTS 1,2 AND 3 ON PL 12R19490; S/T GS14866 TOWN OF KINGSVILLE	20	x	412	0.825	8	x	448	0.352	[redacted]
				[redacted]						40	x	60	0.241	
										40	x	200	0.801	
										6	x	509	0.305	
67	K54	75169-0106	LT	[redacted]	PT LT 5-6 CON 3 EASTERN DIVISION GOSFIELD AS IN R278134 & PT 4, 5 & 8 RD189; KINGSVILLE	20	x	1190	2.341	8	x	1152	0.915	[redacted]
				[redacted]						20	x	50	0.112	
										20	x	50	0.112	
										20	x	80	0.16	
68	***Road 3 East***													

Filed: 2018-12-19
EB-2018-0013
Change Request 1
Schedule 1 Redacted

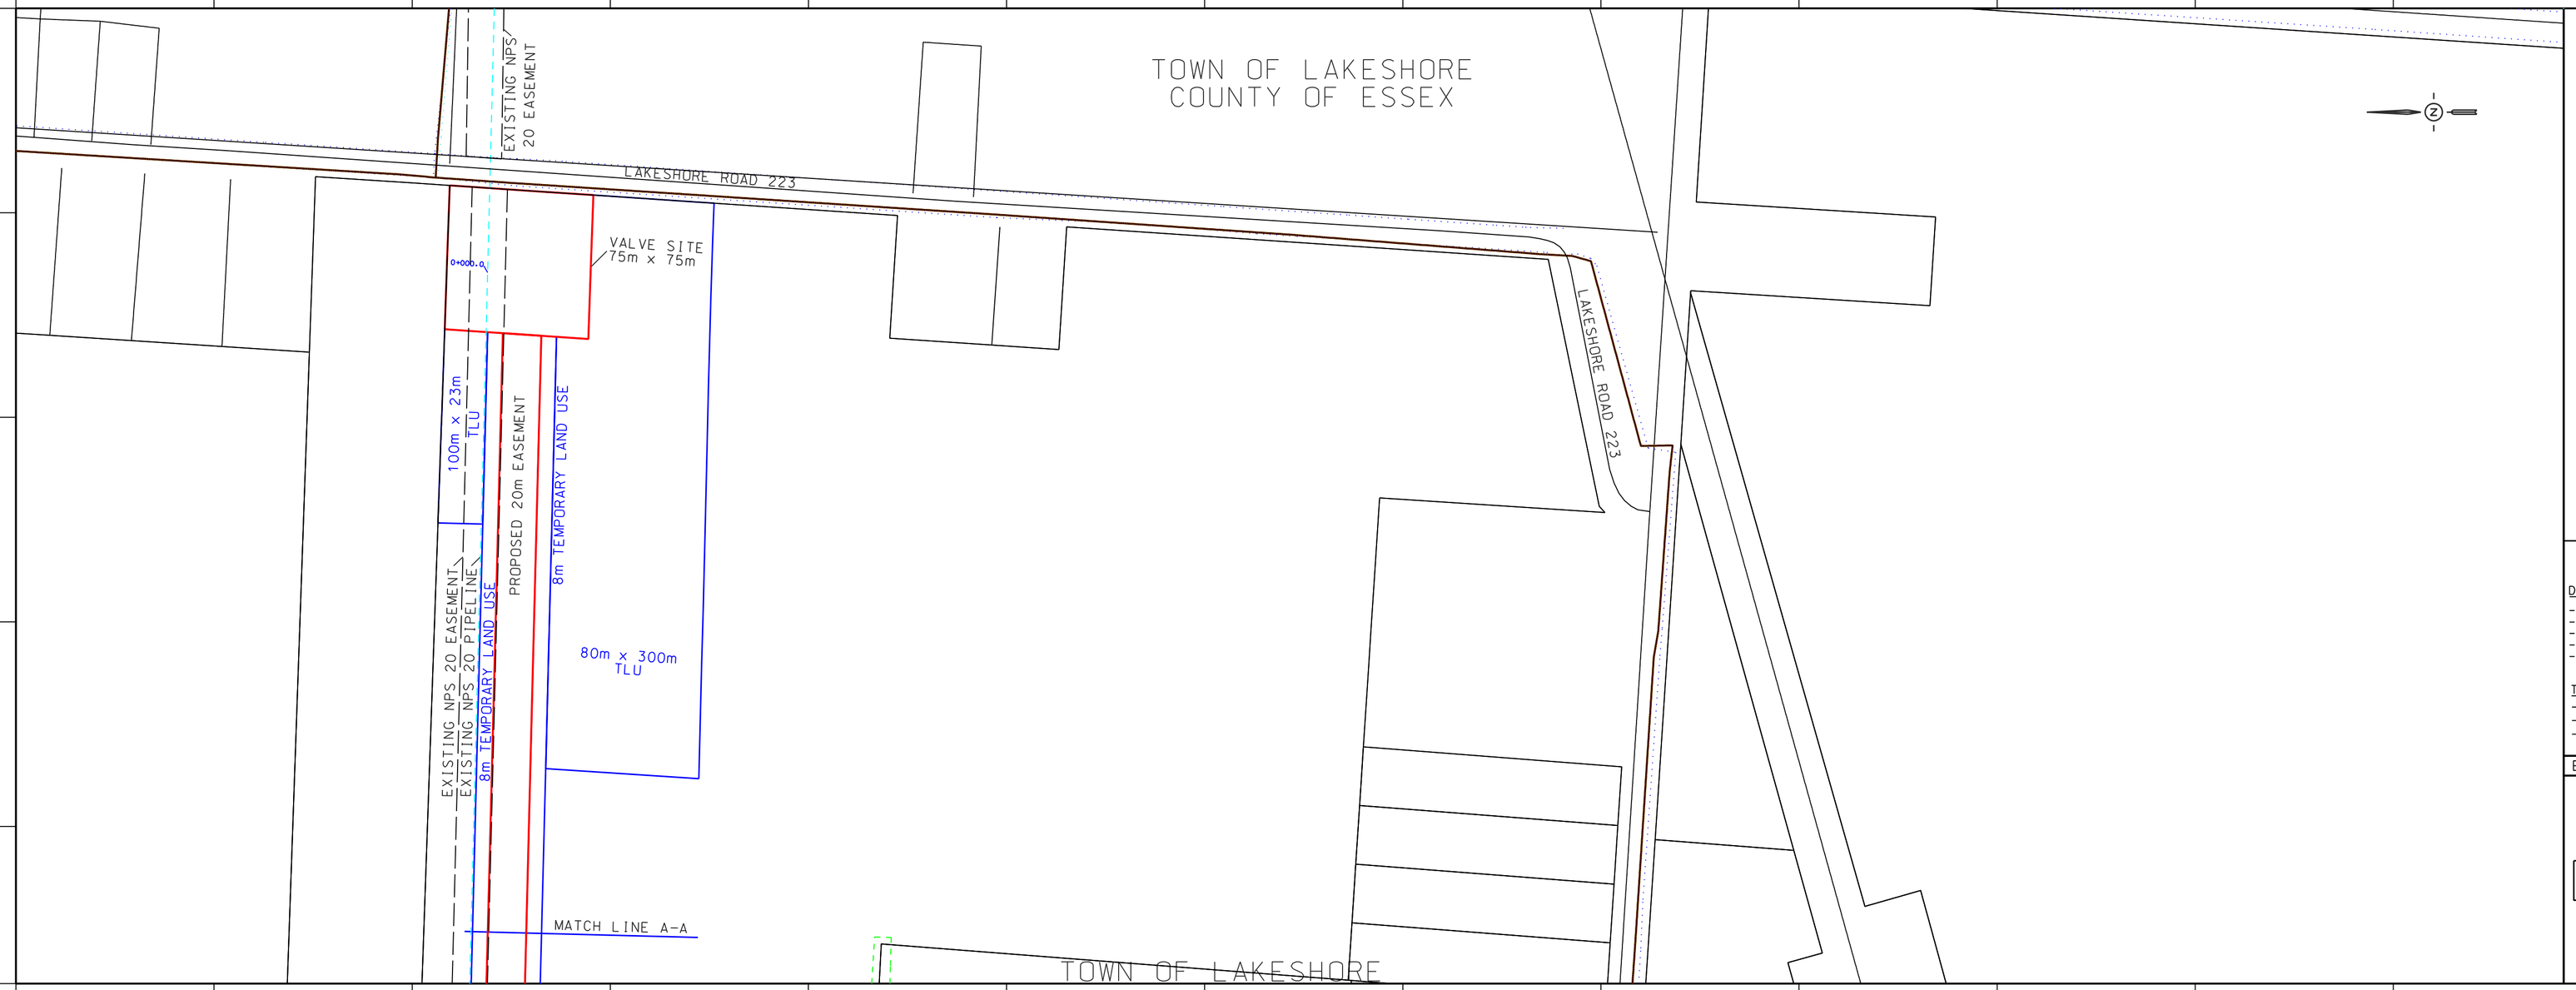

LEGEND

- PROPOSED PIPELINE -
- PROPOSED PIPELINE EASEMENT -
- TEMPORARY LAND USE -
- TEMPORARY LAND USE (NO IMAGERY) -
- NEW TEMPORARY LAND USE -
- EXISTING PIPELINE EASEMENT -
- MOZ AREAS -
- WATERCOURSE -

CONSTRUCTION NOTES:

1) CONTRACTOR RESPONSIBLE FOR ALL UTILITY LOCATES.
2) DEPTH OF MAIN TO BE 1.2m BELOW ℄ OF ROAD OR DITCH. WHICHEVER IS LOWER.
3) MINIMUM DEPTH OF COVER 1.2m. 1.5m FOR ALL ROAD AND CREEK CROSSINGS AND 3.25m FOR RAILWAY CROSSINGS.
4) MAINTAIN MIN. 500mm CLEARANCE BETWEEN PROPOSED MAIN AND OTHER UTILITIES AND UNDERGROUND STRUCTURES THAT ARE CROSSED.
5) ALL CULVERTS, END WALL TREATMENT AND TILE DRAINS REMOVED DURING CONSTRUCTION ARE TO BE RESTORED TO MATCH EXISTING CONDITIONS.
6) RESTORATION INCLUDES TOPSOIL AND SEEDING.
7) RESTORE DRIVEWAYS TO MATCH EXISTING.
8) ALL ASPHALT AREAS TO BE RESTORED TO MATCH EXISTING.
9) RESTORE ALL OPEN DRAINS TO MATCH ORIGINAL GRADE AND CONTOUR CONDITIONS.
10) ALL WORK MUST BE IN ACCORDANCE WITH THE UNION GAS CONSTRUCTION AND MAINTENANCE MANUAL SPECIFICATIONS.
11) ALL WELDS TO BE NON-DESTRUCTIVELY EXAMINED, AS PER C&M 3.6.8.

DESIGN PARAMETERS

DESIGN

- DESIGNED TO CSA Z662-15
- DESIGN FACTOR - 0.8
- LOCATION FACTOR - **
- DESIGN TEMPERATURE - MSC
- DESIGN PRESSURE - 6040 kPa

TEST PRESSURE

- MINIMUM - ****kPa
- MAXIMUM - ****kPa
- TEST DATE:_____

ENGINEER:

PRELIMINARY

12.5 0 25 50 75 METRES
25 0 25 50 75 100 125 250 FEET

No.	DATE	BY	APPD	REMARKS
A	2018-01-12	N.C.	D.T.L.	O.E.B. FILING

REVISIONS

uniongas
An Enbridge Company

NPS 20 KINGSVILLE TRANSMISSION REINFORCEMENT PROJECT
2019 CONSTRUCTION - TOWN OF KINGSVILLE
GENERAL LOCATIONS - OEB FILING

DRAWN BY: MATT WADDICK	DATE: 2017-11-22	PLOT SPEC:	1:2000
CHECKED BY:	DATE:	CAD CODE:	PL1876-OEB-01.dgn
APPROVED BY:	DATE:	FILE REVISION DATE:	2018-01-12
SIZE: STRIP	SHEET: N/A	DRAWING No.:	PL1876-OEB-01

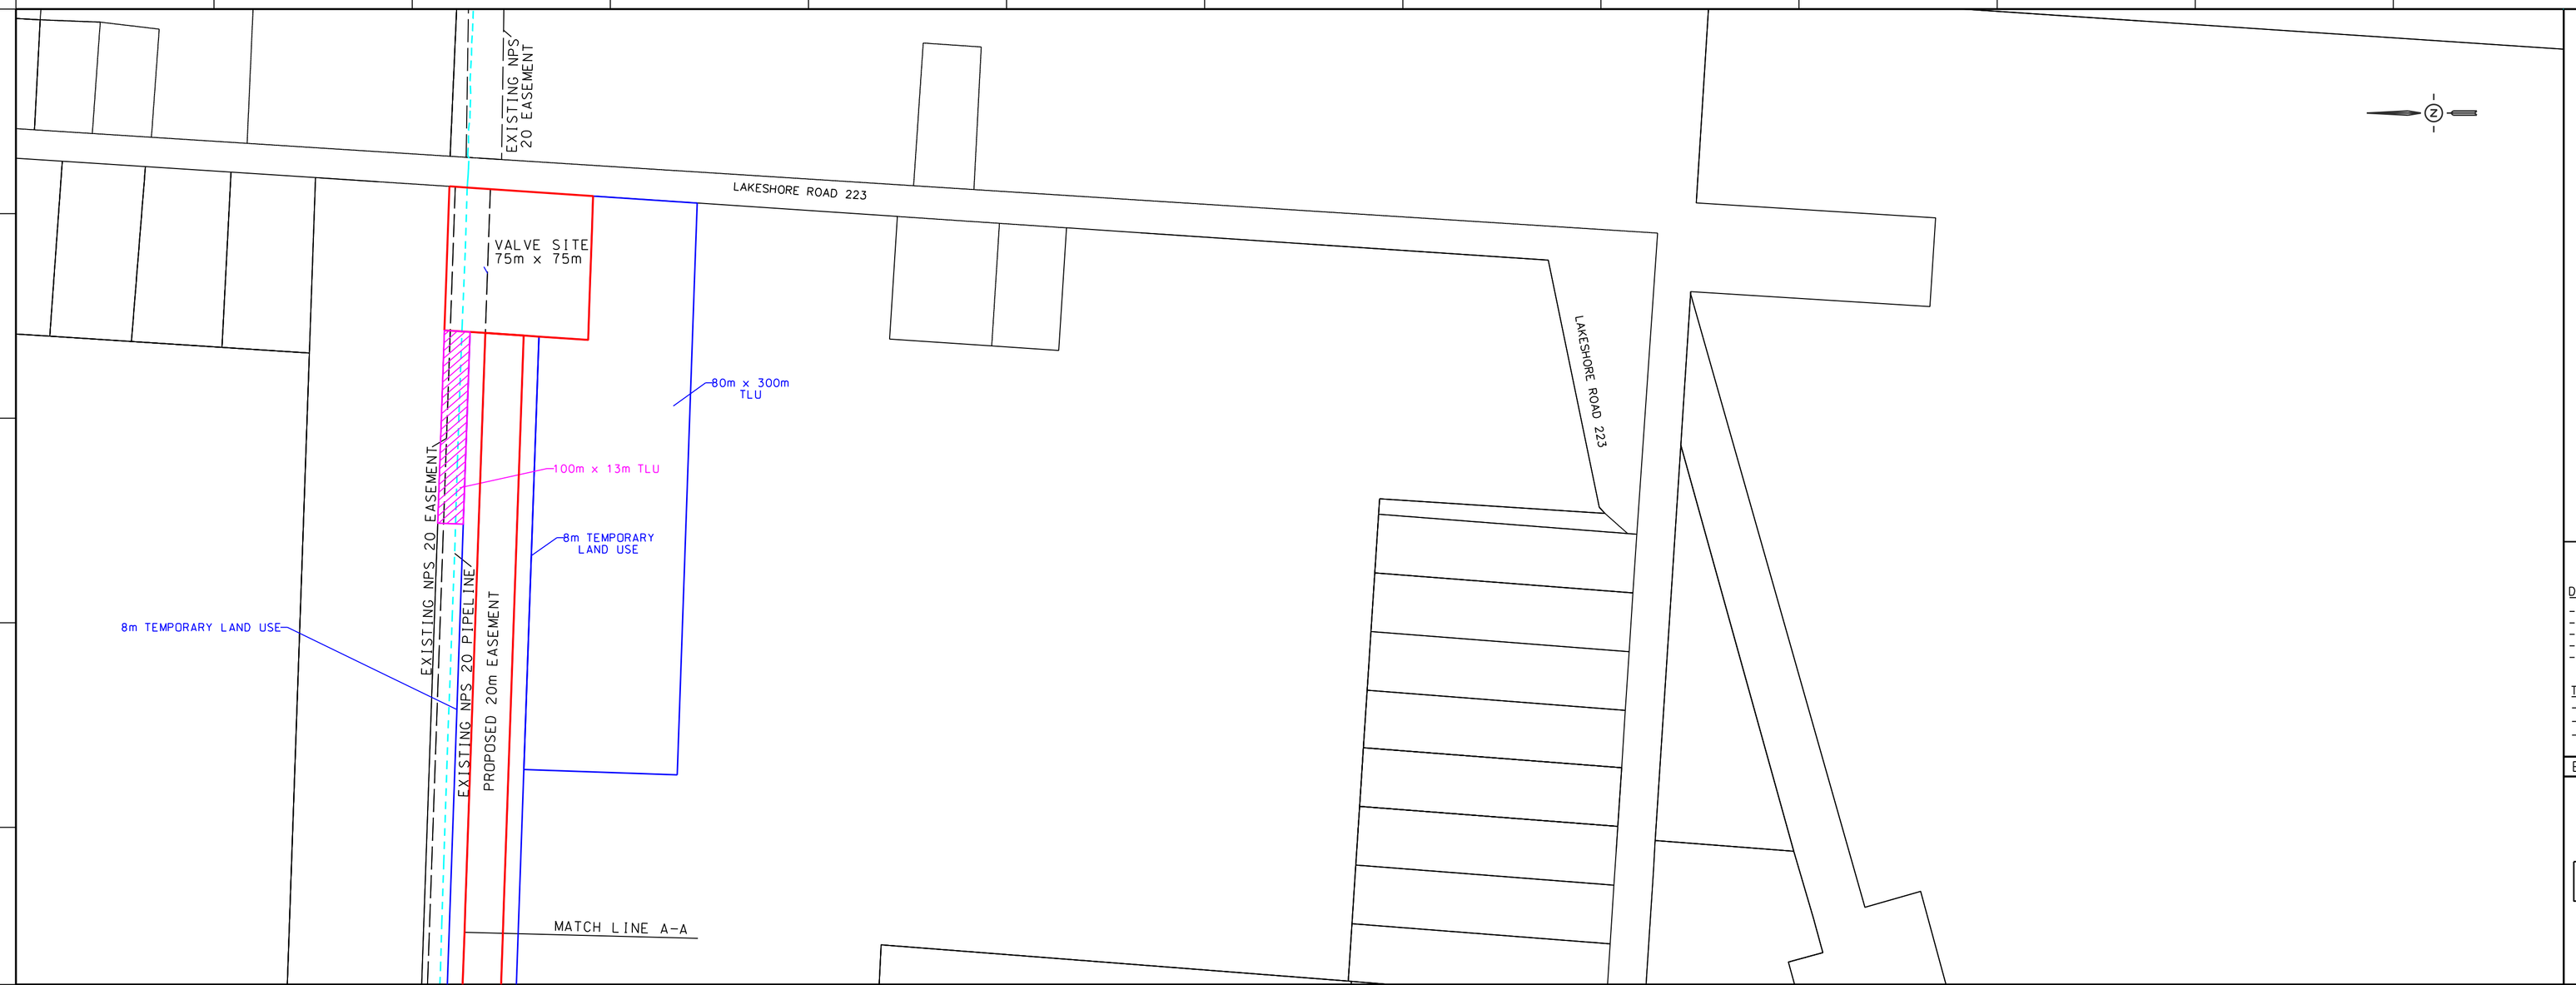

LEGEND

- PROPOSED PIPELINE -
- PROPOSED PIPELINE EASEMENT -
- TEMPORARY LAND USE -
- TEMPORARY LAND USE (NO IMAGERY) -
- NEW TEMPORARY LAND USE -
- EXISTING PIPELINE EASEMENT -
- MOZ AREAS -
- WATERCOURSE -

CONSTRUCTION NOTES:

1) CONTRACTOR RESPONSIBLE FOR ALL UTILITY LOCATES.
2) DEPTH OF MAIN TO BE 1.2m BELOW ℄ OF ROAD OR DITCH. WHICHEVER IS LOWER.
3) MINIMUM DEPTH OF COVER 1.2m. 1.5m FOR ALL ROAD AND CREEK CROSSINGS AND 3.25m FOR RAILWAY CROSSINGS.
4) MAINTAIN MIN. 500mm CLEARANCE BETWEEN PROPOSED MAIN AND OTHER UTILITIES AND UNDERGROUND STRUCTURES THAT ARE CROSSED.
5) ALL CULVERTS, END WALL TREATMENT AND TILE DRAINS REMOVED DURING CONSTRUCTION ARE TO BE RESTORED TO MATCH EXISTING CONDITIONS.
6) RESTORATION INCLUDES TOPSOIL AND SEEDING.
7) RESTORE DRIVEWAYS TO MATCH EXISTING.
8) ALL ASPHALT AREAS TO BE RESTORED TO MATCH EXISTING.
9) RESTORE ALL OPEN DRAINS TO MATCH ORIGINAL GRADE AND CONTOUR CONDITIONS.
10) ALL WORK MUST BE IN ACCORDANCE WITH THE UNION GAS CONSTRUCTION AND MAINTENANCE MANUAL SPECIFICATIONS.
11) ALL WELDS TO BE NON-DESTRUCTIVELY EXAMINED, AS PER C&M 3.6.8.

DESIGN PARAMETERS

DESIGN

- DESIGNED TO CSA Z662-15
- DESIGN FACTOR - 0.8
- LOCATION FACTOR - **
- DESIGN TEMPERATURE - MSC
- DESIGN PRESSURE - 6040 kPa

TEST PRESSURE

- MINIMUM - ****kPa
- MAXIMUM - ****kPa
- TEST DATE:_____

ENGINEER:

PRELIMINARY

12.5 0 25 50 75 METRES
25 0 25 50 75 100 125 250 FEET

No.	DATE	BY	APPD	REMARKS
B	2018-12-07	M.W.	D.T.L.	O.E.B. FILING 2
A	2018-01-12	N.C.	D.T.L.	O.E.B. FILING

REVISIONS

uniongas
An Enbridge Company

NPS 20 KINGSVILLE TRANSMISSION REINFORCEMENT PROJECT
2019 CONSTRUCTION - TOWN OF KINGSVILLE
GENERAL LOCATIONS - OEB FILING

DRAWN BY: MATT WADDICK	DATE: 2017-11-22	PLOT SPEC:	1:2000
CHECKED BY:	DATE:	CAD CODE:	PL1876-OEB-01.dgn
APPROVED BY:	DATE:	FILE REVISION DATE:	2018-12-07
SIZE: STRIP	SHEET: N/A	DRAWING No.:	PL1876-OEB-01

Filed: 2018-12-19
EB-2018-0013
Schedule 12
Page 6 of 18
Change Request I
Redacted

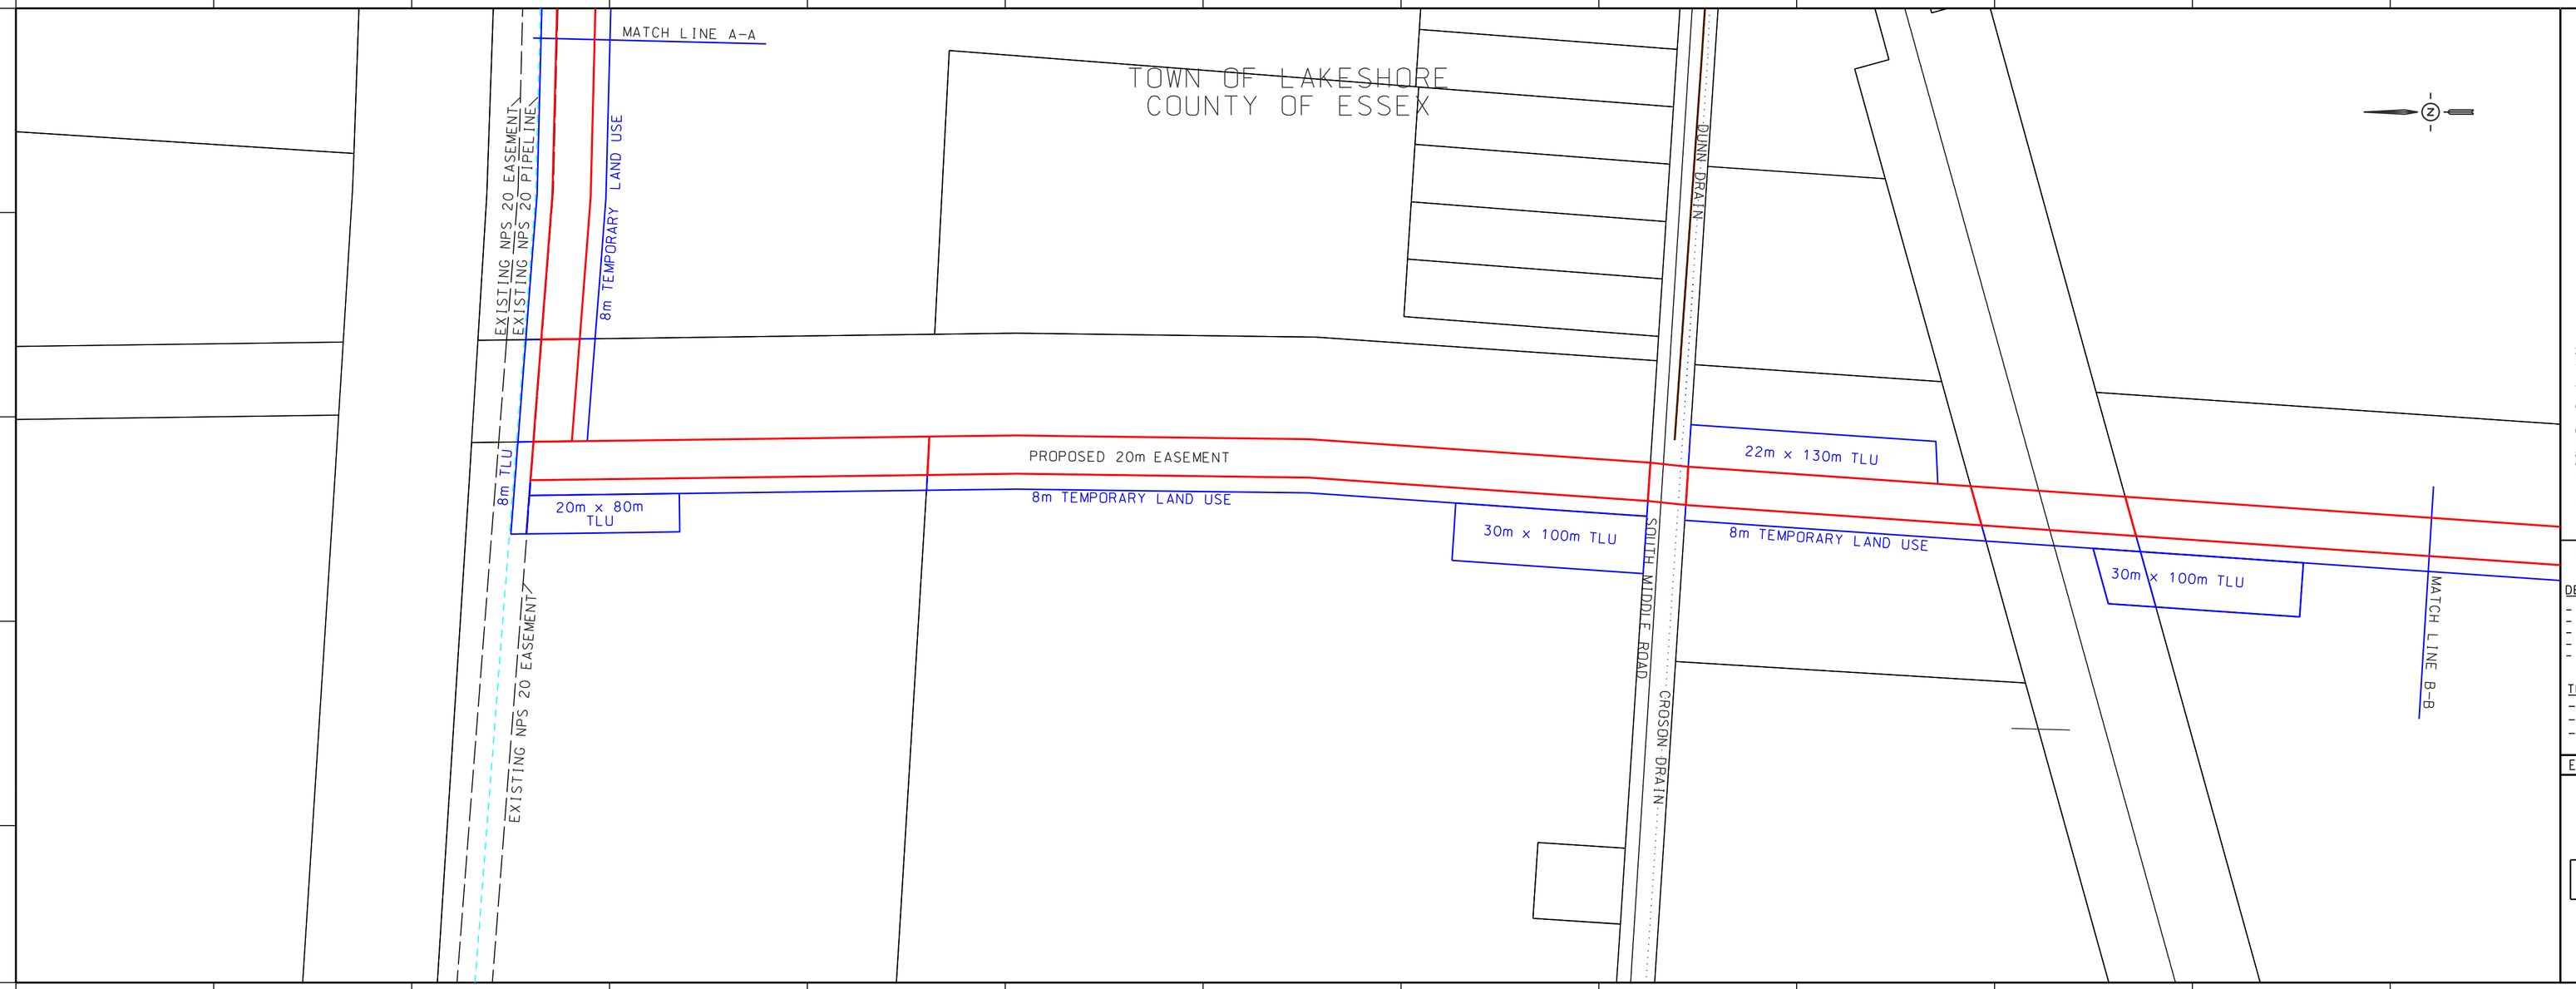

LEGEND

- PROPOSED PIPELINE
- PROPOSED PIPELINE EASEMENT
- TEMPORARY LAND USE
- TEMPORARY LAND USE (NO IMAGERY)
- NEW TEMPORARY LAND USE
- EXISTING PIPELINE EASEMENT
- MOZ AREAS
- WATERCOURSE

CONSTRUCTION NOTES:

1) CONTRACTOR RESPONSIBLE FOR ALL UTILITY LOCATES.
2) DEPTH OF MAIN TO BE 1.2m BELOW ℄ OF ROAD OR DITCH. WHICHEVER IS LOWER.
3) MINIMUM DEPTH OF COVER 1.2m. 1.5m FOR ALL ROAD AND CREEK CROSSINGS AND 3.25m FOR RAILWAY CROSSINGS.
4) MAINTAIN MIN. 500mm CLEARANCE BETWEEN PROPOSED MAIN AND OTHER UTILITIES AND UNDERGROUND STRUCTURES THAT ARE CROSSED.
5) ALL CULVERTS, END WALL TREATMENT AND TILE DRAINS REMOVED DURING CONSTRUCTION ARE TO BE RESTORED TO MATCH EXISTING CONDITIONS.
6) RESTORATION INCLUDES TOPSOIL AND SEEDING.
7) RESTORE DRIVEWAYS TO MATCH EXISTING.
8) ALL ASPHALT AREAS TO BE RESTORED TO MATCH EXISTING.
9) RESTORE ALL OPEN DRAINS TO MATCH ORIGINAL GRADE AND CONTOUR CONDITIONS.
10) ALL WORK MUST BE IN ACCORDANCE WITH THE UNION GAS CONSTRUCTION AND MAINTENANCE MANUAL SPECIFICATIONS.
11) ALL WELDS TO BE NON-DESTRUCTIVELY EXAMINED, AS PER C&M 3.6.8.

DESIGN PARAMETERS

DESIGN

- DESIGNED TO CSA Z662-15
- DESIGN FACTOR - 0.8
- LOCATION FACTOR - **
- DESIGN TEMPERATURE - MSC
- DESIGN PRESSURE - 6040 kPa

TEST PRESSURE

- MINIMUM - ****kPa
- MAXIMUM - ****kPa
- TEST DATE:_____

ENGINEER:

PRELIMINARY

12.5 0 25 50 75 METRES
25 0 25 50 75 100 125 250 FEET

No.	DATE	BY	APPD	REMARKS
A	2018-01-12	N.C.	D.T.L.	O.E.B. FILING

REVISIONS

uniongas
An Enbridge Company

NPS 20 KINGSVILLE TRANSMISSION REINFORCEMENT PROJECT
2019 CONSTRUCTION - TOWN OF KINGSVILLE
GENERAL LOCATIONS - OEB FILING

DRAWN BY: MATT WADDICK	DATE: 2017-11-22	PLOT SPEC:	1:2000
CHECKED BY:	DATE:	CAD CODE:	PL1876-OEB-02.dgn
APPROVED BY:	DATE:	FILE REVISION DATE:	2018-01-12
SIZE: STRIP	SHEET: N/A	DRAWING No.:	PL1876-OEB-02

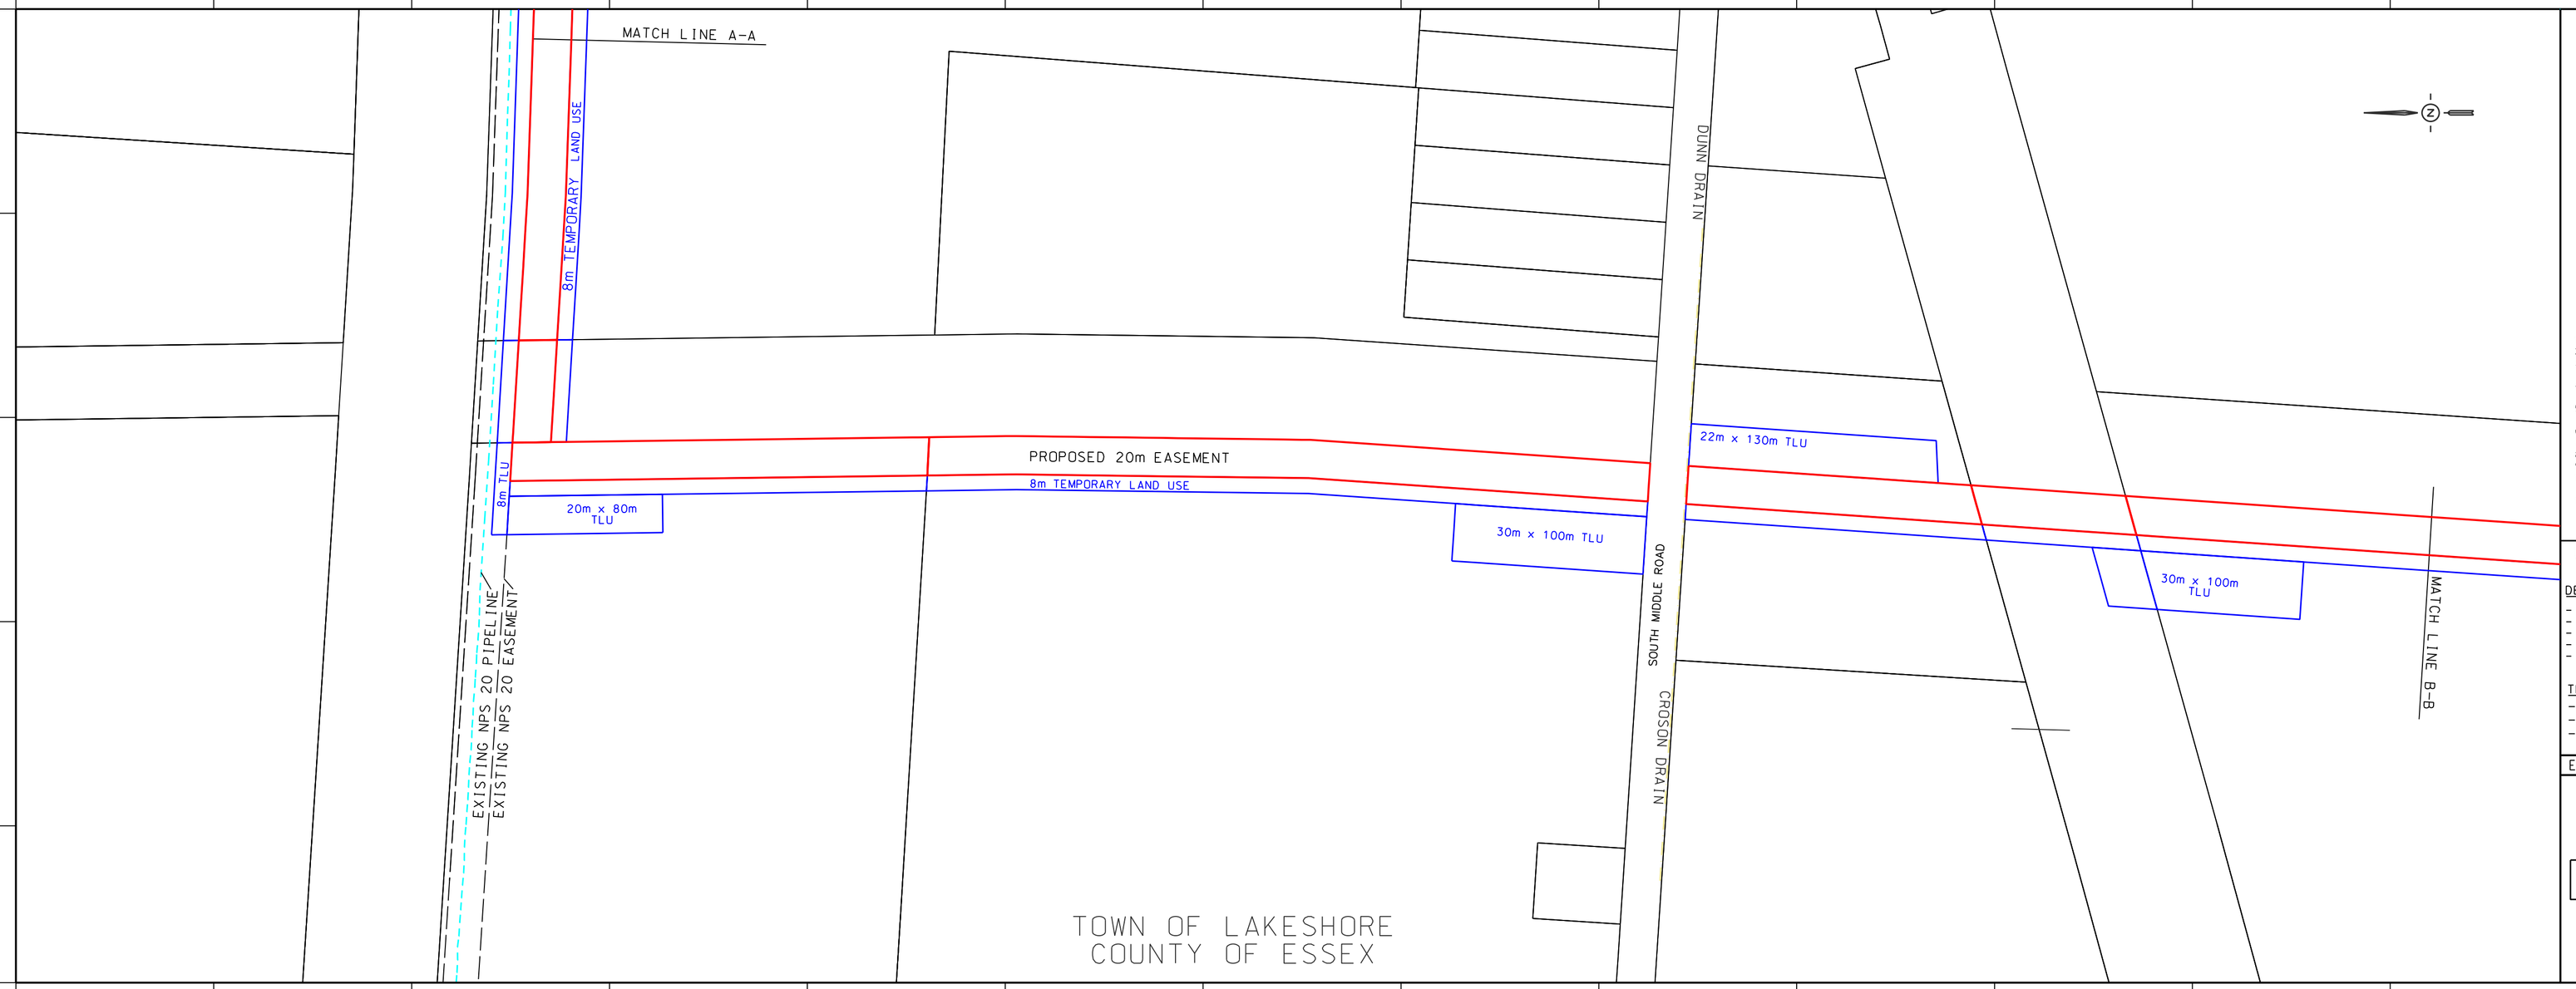

LEGEND

- PROPOSED PIPELINE
- PROPOSED PIPELINE EASEMENT
- TEMPORARY LAND USE
- TEMPORARY LAND USE (NO IMAGERY)
- NEW TEMPORARY LAND USE
- EXISTING PIPELINE EASEMENT
- MOZ AREAS
- WATERCOURSE

CONSTRUCTION NOTES:

1) CONTRACTOR RESPONSIBLE FOR ALL UTILITY LOCATES.
2) DEPTH OF MAIN TO BE 1.2m BELOW ℄ OF ROAD OR DITCH. WHICHEVER IS LOWER.
3) MINIMUM DEPTH OF COVER 1.2m. 1.5m FOR ALL ROAD AND CREEK CROSSINGS AND 3.25m FOR RAILWAY CROSSINGS.
4) MAINTAIN MIN. 500mm CLEARANCE BETWEEN PROPOSED MAIN AND OTHER UTILITIES AND UNDERGROUND STRUCTURES THAT ARE CROSSED.
5) ALL CULVERTS, END WALL TREATMENT AND TILE DRAINS REMOVED DURING CONSTRUCTION ARE TO BE RESTORED TO MATCH EXISTING CONDITIONS.
6) RESTORATION INCLUDES TOPSOIL AND SEEDING.
7) RESTORE DRIVEWAYS TO MATCH EXISTING.
8) ALL ASPHALT AREAS TO BE RESTORED TO MATCH EXISTING.
9) RESTORE ALL OPEN DRAINS TO MATCH ORIGINAL GRADE AND CONTOUR CONDITIONS.
10) ALL WORK MUST BE IN ACCORDANCE WITH THE UNION GAS CONSTRUCTION AND MAINTENANCE MANUAL SPECIFICATIONS.
11) ALL WELDS TO BE NON-DESTRUCTIVELY EXAMINED, AS PER C&M 3.6.8.

DESIGN PARAMETERS

DESIGN

- DESIGNED TO CSA Z662-15
- DESIGN FACTOR - 0.8
- LOCATION FACTOR - **
- DESIGN TEMPERATURE - MSC
- DESIGN PRESSURE - 6040 kPa

TEST PRESSURE

- MINIMUM - ****kPa
- MAXIMUM - ****kPa
- TEST DATE:_____

ENGINEER:

PRELIMINARY

12.5 0 25 50 75 METRES
25 0 25 50 75 100 125 250 FEET

No.	DATE	BY	APPD	REMARKS
B	2018-12-07	M.W.	D.T.L.	O.E.B. FILING 2
A	2018-01-12	N.C.	D.T.L.	O.E.B. FILING

REVISIONS

uniongas
An Enbridge Company

NPS 20 KINGSVILLE TRANSMISSION REINFORCEMENT PROJECT
2019 CONSTRUCTION - TOWN OF KINGSVILLE
GENERAL LOCATIONS - OEB FILING

DRAWN BY: MATT WADDICK	DATE: 2017-11-22	PLOT SPEC:	1:2000
CHECKED BY:	DATE:	CAD CODE:	PL1876-OEB-02.dgn
APPROVED BY:	DATE:	FILE REVISION DATE:	2018-01-12
SIZE: STRIP	SHEET: N/A	DRAWING No.:	PL1876-OEB-02

Filed: 2018-12-19
EB-2018-0013
Schedule 1
Change Request
Attachment 1 Redacted
Page 2 of 18

TOWN OF LAKESHORE
COUNTY OF ESSEX

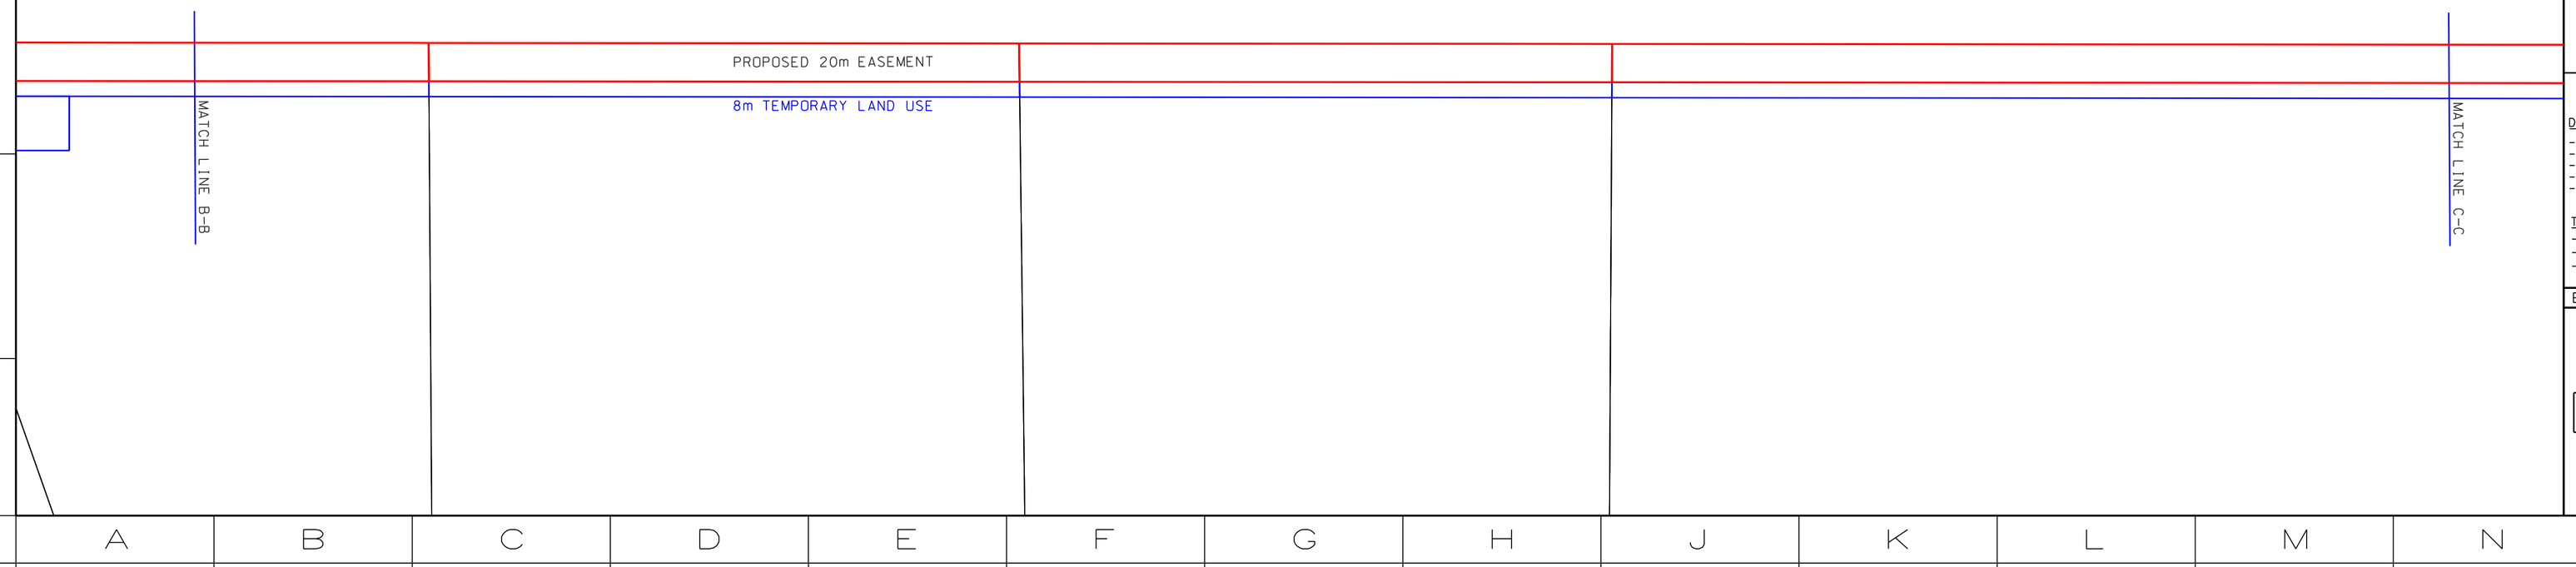

LEGEND

PROPOSED PIPELINE	-	
PROPOSED PIPELINE EASEMENT	-	
TEMPORARY LAND USE	-	
TEMPORARY LAND USE (NO IMAGERY)	-	
NEW TEMPORARY LAND USE	-	
EXISTING PIPELINE EASEMENT	-	
MOZ AREAS	-	
WATERCOURSE	-	

CONSTRUCTION NOTES:

1) CONTRACTOR RESPONSIBLE FOR ALL UTILITY LOCATES.
2) DEPTH OF MAIN TO BE 1.2m BELOW ℄ OF ROAD OR DITCH. WHICHEVER IS LOWER.
3) MINIMUM DEPTH OF COVER 1.2m. 1.5m FOR ALL ROAD AND CREEK CROSSINGS AND 3.25m FOR RAILWAY CROSSINGS.
4) MAINTAIN MIN. 500mm CLEARANCE BETWEEN PROPOSED MAIN AND OTHER UTILITIES AND UNDERGROUND STRUCTURES THAT ARE CROSSED.
5) ALL CULVERTS, END WALL TREATMENT AND TILE DRAINS REMOVED DURING CONSTRUCTION ARE TO BE RESTORED TO MATCH EXISTING CONDITIONS.
6) RESTORATION INCLUDES TOPSOIL AND SEEDING.
7) RESTORE DRIVEWAYS TO MATCH EXISTING.
8) ALL ASPHALT AREAS TO BE RESTORED TO MATCH EXISTING.
9) RESTORE ALL OPEN DRAINS TO MATCH ORIGINAL GRADE AND CONTOUR CONDITIONS.
10) ALL WORK MUST BE IN ACCORDANCE WITH THE UNION GAS CONSTRUCTION AND MAINTENANCE MANUAL SPECIFICATIONS.
11) ALL WELDS TO BE NON-DESTRUCTIVELY EXAMINED, AS PER C&M 3.6.8.

DESIGN PARAMETERS

DESIGN

- DESIGNED TO CSA Z662-15
- DESIGN FACTOR - 0.8
- LOCATION FACTOR - **
- DESIGN TEMPERATURE - MSC
- DESIGN PRESSURE - 6040 kPa

TEST PRESSURE

- MINIMUM - ****kPa
- MAXIMUM - ****kPa
- TEST DATE:_____

ENGINEER:

PRELIMINARY

12.5 0 25 50 75 METRES
25 0 25 50 75 100 125 250 FEET

No.	DATE	BY	APPD	REMARKS
A	2018-01-12	N.C.	D.T.L.	OEB FILING

REVISIONS

uniongas
An Enbridge Company

NPS 20 KINGSVILLE TRANSMISSION REINFORCEMENT PROJECT
2019 CONSTRUCTION - TOWN OF KINGSVILLE
GENERAL LOCATIONS - OEB FILING

DRAWN BY: MATT WADDICK	DATE: 2017-11-22	PLOT SPEC:	1:2000
CHECKED BY:	DATE:	CAD CODE:	PL1876-OEB-03.dgn
APPROVED BY:	DATE:	FILE REVISION DATE:	2018-01-12
SIZE: STRIP	SHEET: N/A	DRAWING No.:	PL1876-OEB-03

TOWN OF LAKESHORE
COUNTY OF ESSEX

PROPOSED 20m EASEMENT
8m TEMPORARY LAND USE
MATCH LINE B-B
MATCH LINE C-C

LEGEND
PROPOSED PIPELINE -
PROPOSED PIPELINE EASEMENT -
TEMPORARY LAND USE -
TEMPORARY LAND USE (NO IMAGERY) -
NEW TEMPORARY LAND USE -
EXISTING PIPELINE EASEMENT -
MOZ AREAS -
WATERCOURSE -

CONSTRUCTION NOTES:
1) CONTRACTOR RESPONSIBLE FOR ALL UTILITY LOCATES.
2) DEPTH OF MAIN TO BE 1.2m BELOW ℄ OF ROAD OR DITCH. WHICHEVER IS LOWER.
3) MINIMUM DEPTH OF COVER 1.2m. 1.5m FOR ALL ROAD AND CREEK CROSSINGS AND 3.25m FOR RAILWAY CROSSINGS.
4) MAINTAIN MIN. 500mm CLEARANCE BETWEEN PROPOSED MAIN AND OTHER UTILITIES AND UNDERGROUND STRUCTURES THAT ARE CROSSED.
5) ALL CULVERTS, END WALL TREATMENT AND TILE DRAINS REMOVED DURING CONSTRUCTION ARE TO BE RESTORED TO MATCH EXISTING CONDITIONS.
6) RESTORATION INCLUDES TOPSOIL AND SEEDING.
7) RESTORE DRIVEWAYS TO MATCH EXISTING.
8) ALL ASPHALT AREAS TO BE RESTORED TO MATCH EXISTING.
9) RESTORE ALL OPEN DRAINS TO MATCH ORIGINAL GRADE AND CONTOUR CONDITIONS.
10) ALL WORK MUST BE IN ACCORDANCE WITH THE UNION GAS CONSTRUCTION AND MAINTENANCE MANUAL SPECIFICATIONS.
11) ALL WELDS TO BE NON-DESTRUCTIVELY EXAMINED, AS PER C&M 3.6.8.

DESIGN PARAMETERS
DESIGN
- DESIGNED TO CSA Z662-15
- DESIGN FACTOR - 0.8
- LOCATION FACTOR - **
- DESIGN TEMPERATURE - MSC
- DESIGN PRESSURE - 6040 kPa

TEST PRESSURE
- MINIMUM - ****kPa
- MAXIMUM - ****kPa
- TEST DATE:_____

ENGINEER:
PRELIMINARY

12.5 0 25 50 75 METRES
25 0 25 50 75 100 125 250 FEET

No.	DATE	BY	APPD	REMARKS
B	2018-12-07	M.W.	D.T.L.	OEB FILING 2
A	2018-01-12	N.C.	D.T.L.	OEB FILING

REVISIONS
uniongas
An Enbridge Company
NPS 20 KINGSVILLE TRANSMISSION REINFORCEMENT PROJECT
2019 CONSTRUCTION - TOWN OF KINGSVILLE
GENERAL LOCATIONS - OEB FILING
DRAWN BY: MATT WADDICK | DATE: 2017-11-22 | PLOT SPEC: 1:2000
CHECKED BY: | DATE: | CAD CODE: PL1876-OEB-03.dgn
APPROVED BY: | DATE: | FILE REVISION DATE: 2018-12-07
SIZE: STRIP | SHEET: N/A | DRAWING No.: PL1876-OEB-03

Filed: 2018-12-19
EB-2018-0013
Schedule 2
Page 2 of 18
Change Request 1
Redacted

TOWN OF LAKESHORE
COUNTY OF ESSEX

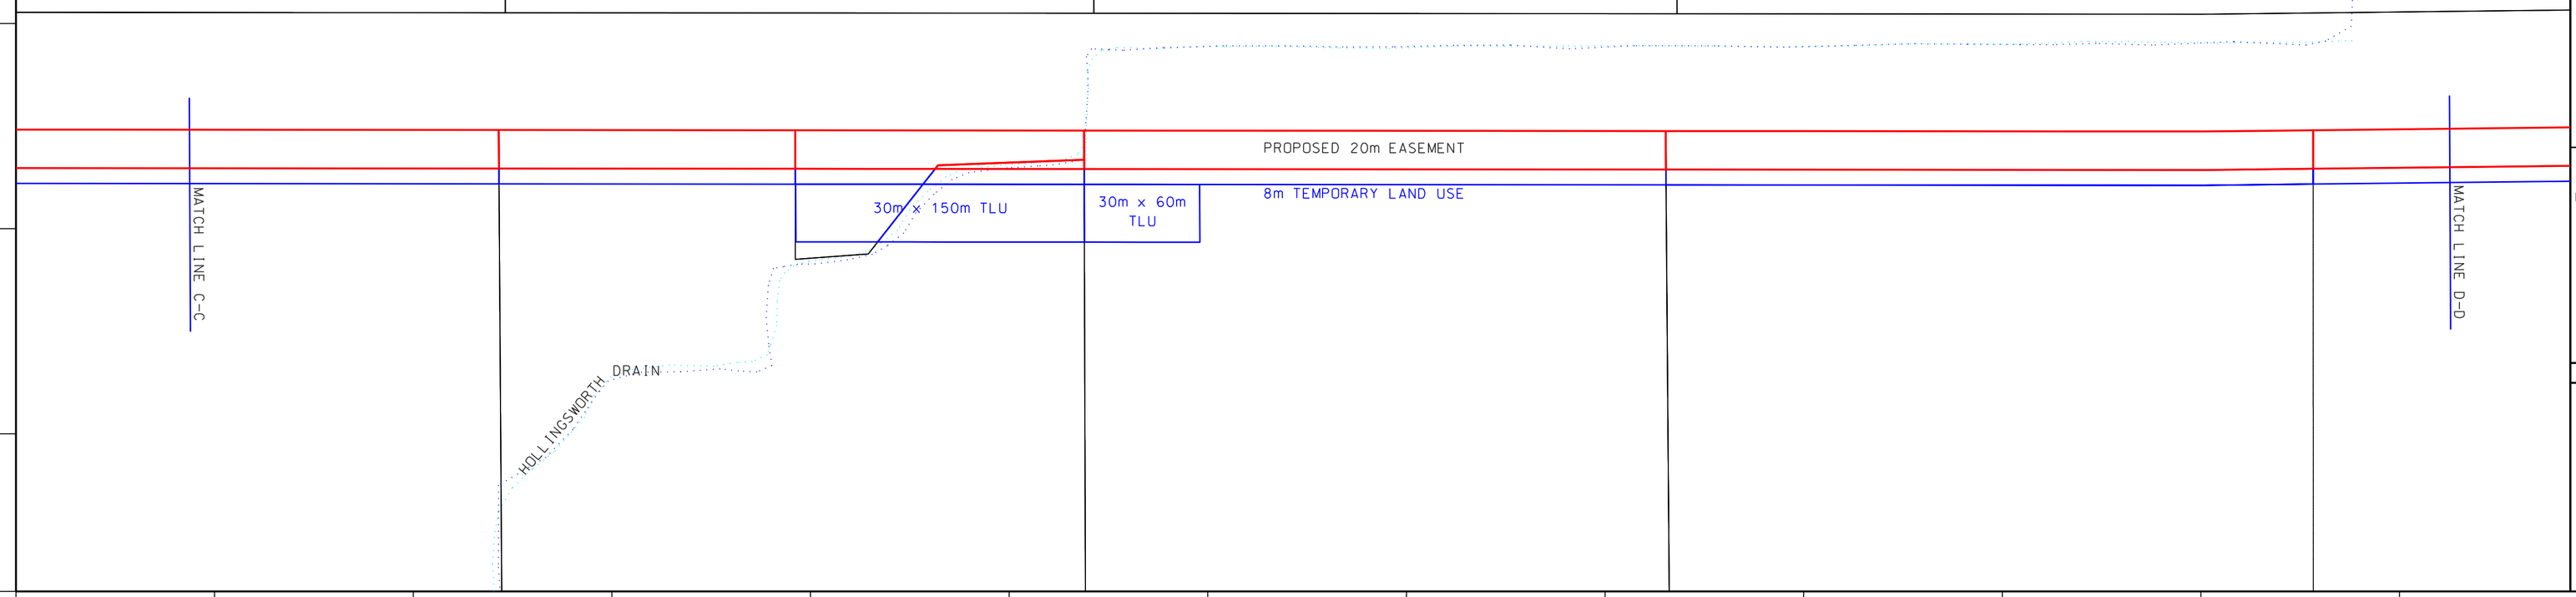

LEGEND

- PROPOSED PIPELINE -
- PROPOSED PIPELINE EASEMENT -
- TEMPORARY LAND USE -
- TEMPORARY LAND USE (NO IMAGERY) -
- NEW TEMPORARY LAND USE -
- EXISTING PIPELINE EASEMENT -
- MOZ AREAS -
- WATERCOURSE -

CONSTRUCTION NOTES:

1) CONTRACTOR RESPONSIBLE FOR ALL UTILITY LOCATES.
2) DEPTH OF MAIN TO BE 1.2m BELOW ℄ OF ROAD OR DITCH. WHICHEVER IS LOWER.
3) MINIMUM DEPTH OF COVER 1.2m. 1.5m FOR ALL ROAD AND CREEK CROSSINGS AND 3.25m FOR RAILWAY CROSSINGS.
4) MAINTAIN MIN. 500mm CLEARANCE BETWEEN PROPOSED MAIN AND OTHER UTILITIES AND UNDERGROUND STRUCTURES THAT ARE CROSSED.
5) ALL CULVERTS, END WALL TREATMENT AND TILE DRAINS REMOVED DURING CONSTRUCTION ARE TO BE RESTORED TO MATCH EXISTING CONDITIONS.
6) RESTORATION INCLUDES TOPSOIL AND SEEDING.
7) RESTORE DRIVEWAYS TO MATCH EXISTING.
8) ALL ASPHALT AREAS TO BE RESTORED TO MATCH EXISTING.
9) RESTORE ALL OPEN DRAINS TO MATCH ORIGINAL GRADE AND CONTOUR CONDITIONS.
10) ALL WORK MUST BE IN ACCORDANCE WITH THE UNION GAS CONSTRUCTION AND MAINTENANCE MANUAL SPECIFICATIONS.
11) ALL WELDS TO BE NON-DESTRUCTIVELY EXAMINED, AS PER C&M 3.6.8.

DESIGN PARAMETERS

DESIGN

- DESIGNED TO CSA Z662-15
- DESIGN FACTOR - 0.8
- LOCATION FACTOR - **
- DESIGN TEMPERATURE - MSC
- DESIGN PRESSURE - 6040 kPa

TEST PRESSURE

- MINIMUM - ****kPa
- MAXIMUM - ****kPa
- TEST DATE:_____

ENGINEER:

PRELIMINARY

12.5 0 25 50 75 METRES
25 0 25 50 75 100 125 250 FEET

No.	DATE	BY	APP'D	REMARKS
A	2018-01-12	N.C.	D.T.L.	O.E.B. FILING

REVISIONS

uniongas
An Enbridge Company

NPS 20 KINGSVILLE TRANSMISSION REINFORCEMENT PROJECT
2019 CONSTRUCTION - TOWN OF KINGSVILLE
GENERAL LOCATIONS - OEB FILING

DRAWN BY: MATT WADDICK	DATE: 2017-11-22	PLOT SPEC:	1:2000
CHECKED BY:	DATE:	CAD CODE:	PL1876-OEB-04.dgn
APPROVED BY:	DATE:	FILE REVISION DATE:	2018-01-12
SIZE: STRIP	SHEET: N/A	DRAWING No.:	PL1876-OEB-04

TOWN OF LAKESHORE
COUNTY OF ESSEX

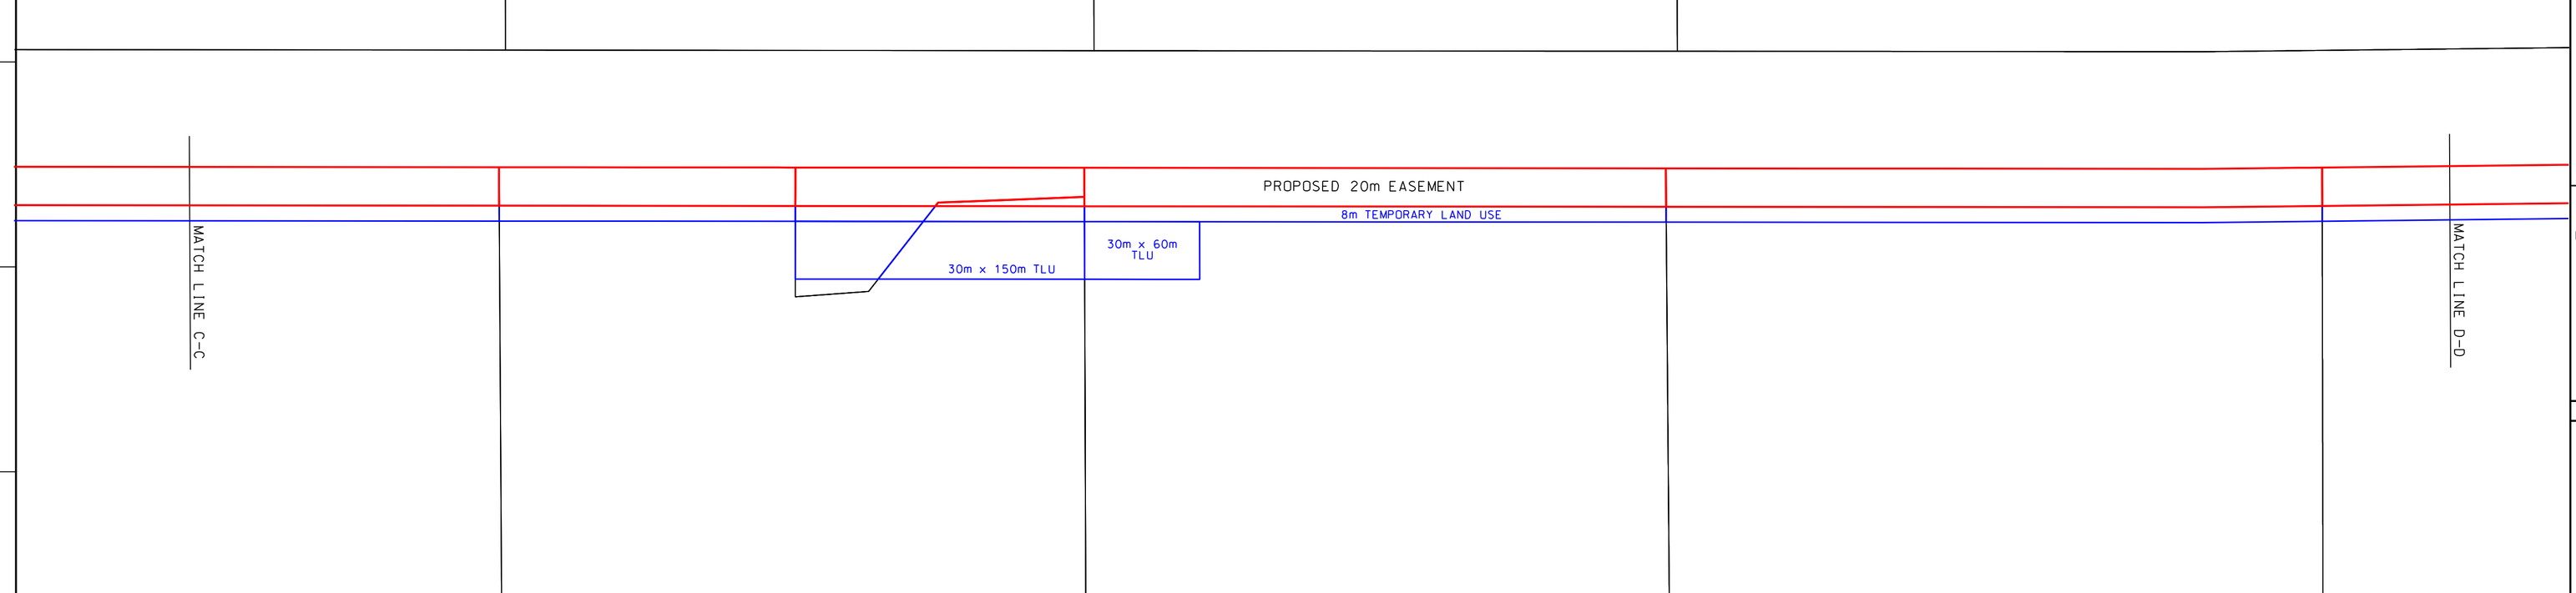

LEGEND
PROPOSED PIPELINE -
PROPOSED PIPELINE EASEMENT -
TEMPORARY LAND USE -
TEMPORARY LAND USE (NO IMAGERY) -
NEW TEMPORARY LAND USE -
EXISTING PIPELINE EASEMENT -
MOZ AREAS -
WATERCOURSE -

CONSTRUCTION NOTES:
1) CONTRACTOR RESPONSIBLE FOR ALL UTILITY LOCATES.
2) DEPTH OF MAIN TO BE 1.2m BELOW ℄ OF ROAD OR DITCH. WHICHEVER IS LOWER.
3) MINIMUM DEPTH OF COVER 1.2m. 1.5m FOR ALL ROAD AND CREEK CROSSINGS AND 3.25m FOR RAILWAY CROSSINGS.
4) MAINTAIN MIN. 500mm CLEARANCE BETWEEN PROPOSED MAIN AND OTHER UTILITIES AND UNDERGROUND STRUCTURES THAT ARE CROSSED.
5) ALL CULVERTS, END WALL TREATMENT AND TILE DRAINS REMOVED DURING CONSTRUCTION ARE TO BE RESTORED TO MATCH EXISTING CONDITIONS.
6) RESTORATION INCLUDES TOPSOIL AND SEEDING.
7) RESTORE DRIVEWAYS TO MATCH EXISTING.
8) ALL ASPHALT AREAS TO BE RESTORED TO MATCH EXISTING.
9) RESTORE ALL OPEN DRAINS TO MATCH ORIGINAL GRADE AND CONTOUR CONDITIONS.
10) ALL WORK MUST BE IN ACCORDANCE WITH THE UNION GAS CONSTRUCTION AND MAINTENANCE MANUAL SPECIFICATIONS.
11) ALL WELDS TO BE NON-DESTRUCTIVELY EXAMINED, AS PER C&M 3.6.8.

DESIGN PARAMETERS
DESIGN
- DESIGNED TO CSA Z662-15
- DESIGN FACTOR - 0.8
- LOCATION FACTOR - **
- DESIGN TEMPERATURE - MSC
- DESIGN PRESSURE - 6040 kPa
TEST PRESSURE
- MINIMUM - ****kPa
- MAXIMUM - ****kPa
- TEST DATE:_____
ENGINEER:
PRELIMINARY

12.5 0 25 50 75 METRES
25 0 25 50 75 100 125 250 FEET

No.	DATE	BY	APP'D	REMARKS
B	2018-12-07	M.W.	D.T.L.	O.E.B. FILING 2
A	2018-01-12	N.C.	D.T.L.	O.E.B. FILING

REVISIONS
uniongas
An Enbridge Company
NPS 20 KINGSVILLE TRANSMISSION REINFORCEMENT PROJECT
2019 CONSTRUCTION - TOWN OF KINGSVILLE
GENERAL LOCATIONS - OEB FILING

DRAWN BY: MATT WADDICK	DATE: 2017-11-22	PLOT SPEC:	1:2000
CHECKED BY:	DATE:	CAD CODE:	PL1876-OEB-04.dgn
APPROVED BY:	DATE:	FILE REVISION DATE:	2018-12-07
SIZE: STRIP	SHEET: N/A	DRAWING No.:	PL1876-OEB-04

Filed: 2018-12-19
EB-2018-0013
Schedule 1
Change Request
Redacted
Page 12 of 18

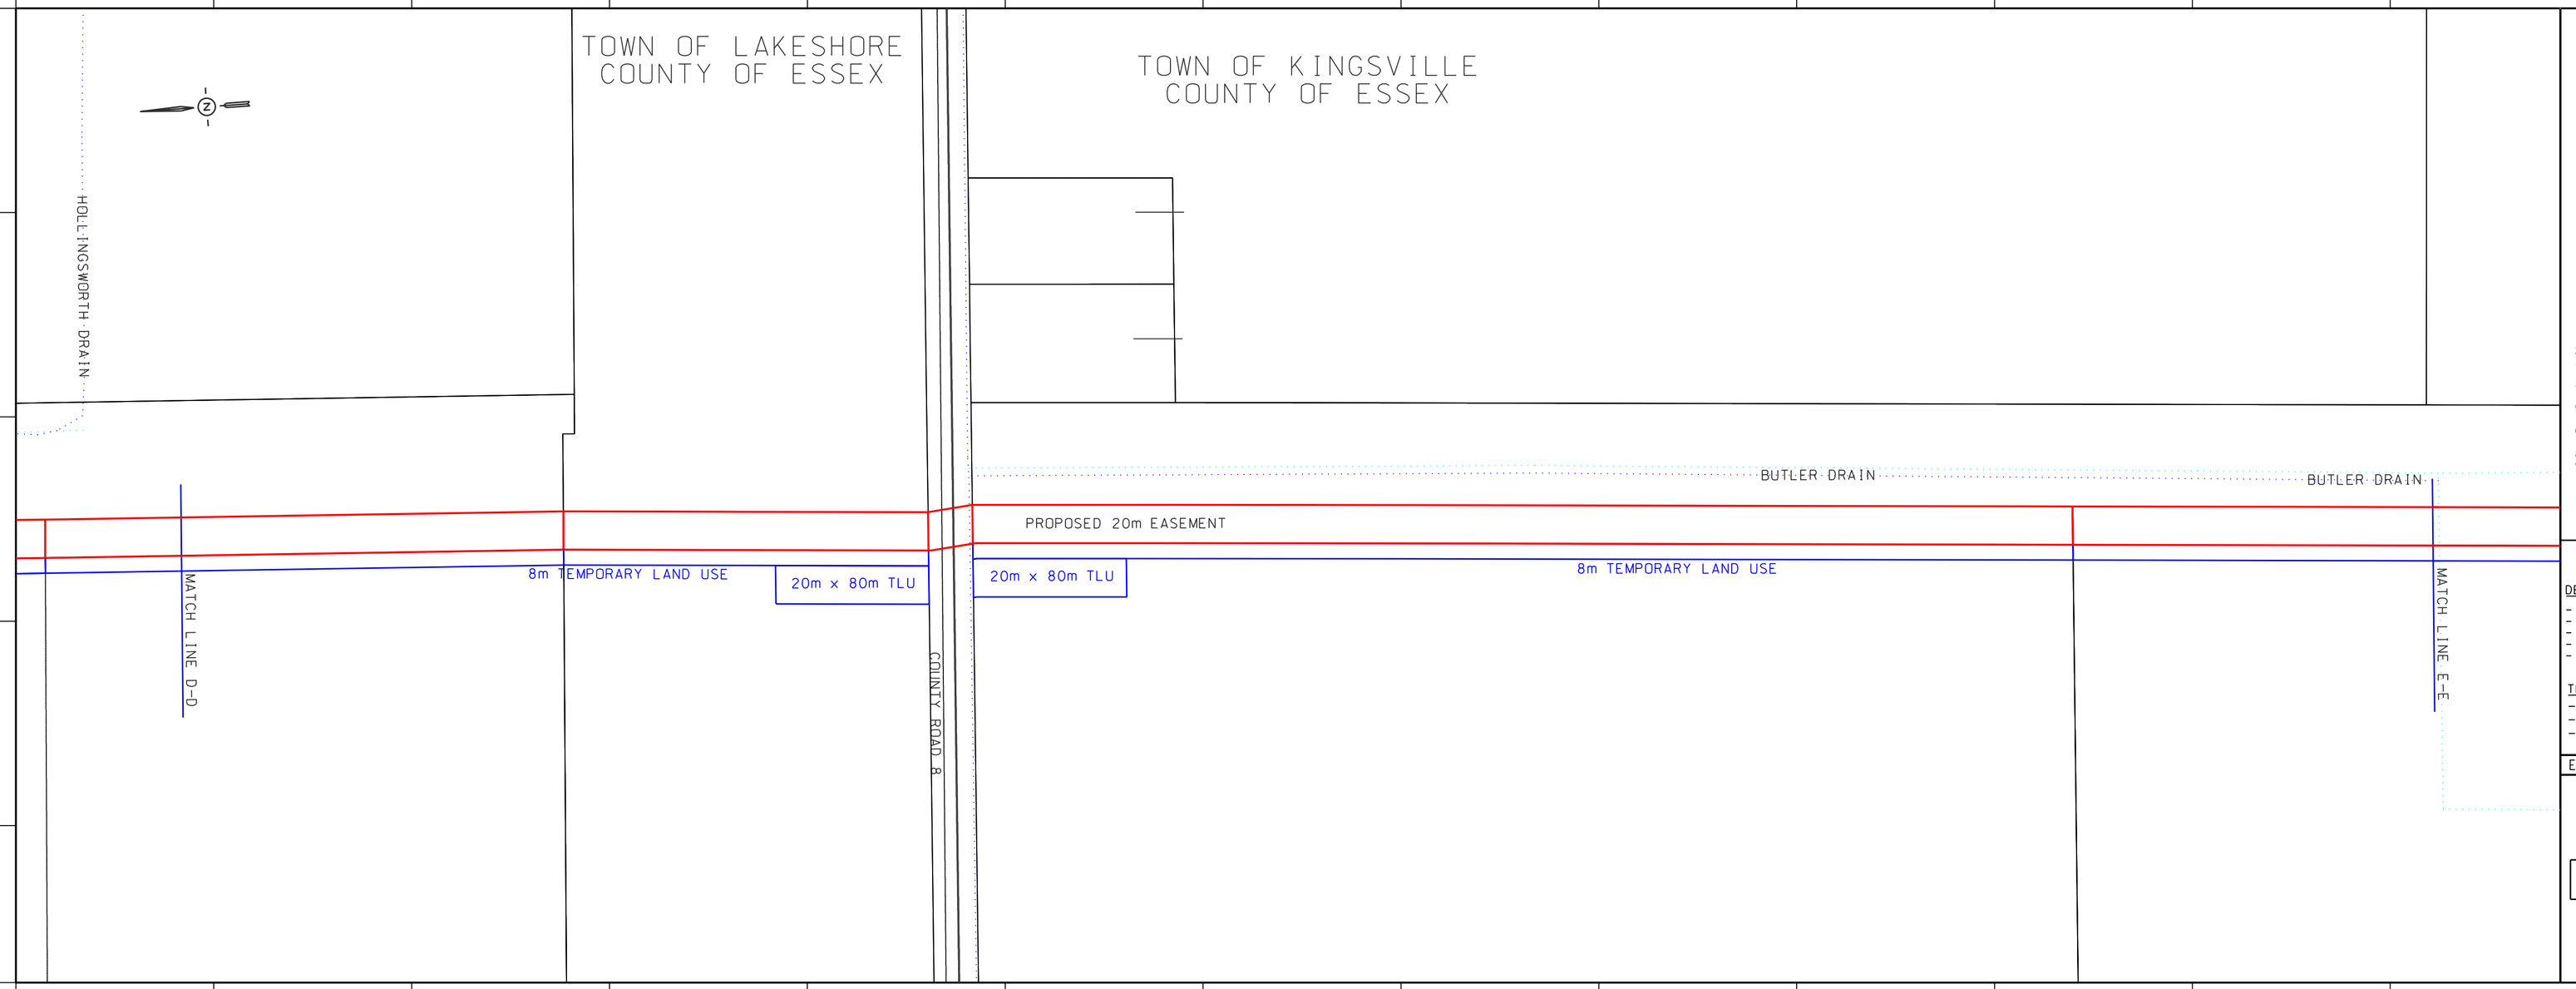

LEGEND

- PROPOSED PIPELINE
- PROPOSED PIPELINE EASEMENT
- TEMPORARY LAND USE
- TEMPORARY LAND USE (NO IMAGERY)
- NEW TEMPORARY LAND USE
- EXISTING PIPELINE EASEMENT
- MOZ AREAS
- WATERCOURSE

CONSTRUCTION NOTES:

1) CONTRACTOR RESPONSIBLE FOR ALL UTILITY LOCATES.
2) DEPTH OF MAIN TO BE 1.2m BELOW ℄ OF ROAD OR DITCH. WHICHEVER IS LOWER.
3) MINIMUM DEPTH OF COVER 1.2m. 1.5m FOR ALL ROAD AND CREEK CROSSINGS AND 3.25m FOR RAILWAY CROSSINGS.
4) MAINTAIN MIN. 500mm CLEARANCE BETWEEN PROPOSED MAIN AND OTHER UTILITIES AND UNDERGROUND STRUCTURES THAT ARE CROSSED.
5) ALL CULVERTS, END WALL TREATMENT AND TILE DRAINS REMOVED DURING CONSTRUCTION ARE TO BE RESTORED TO MATCH EXISTING CONDITIONS.
6) RESTORATION INCLUDES TOPSOIL AND SEEDING.
7) RESTORE DRIVEWAYS TO MATCH EXISTING.
8) ALL ASPHALT AREAS TO BE RESTORED TO MATCH EXISTING.
9) RESTORE ALL OPEN DRAINS TO MATCH ORIGINAL GRADE AND CONTOUR CONDITIONS.
10) ALL WORK MUST BE IN ACCORDANCE WITH THE UNION GAS CONSTRUCTION AND MAINTENANCE MANUAL SPECIFICATIONS.
11) ALL WELDS TO BE NON-DESTRUCTIVELY EXAMINED, AS PER C&M 3.6.8.

DESIGN PARAMETERS

DESIGN

- DESIGNED TO CSA Z662-15
- DESIGN FACTOR - 0.8
- LOCATION FACTOR - **
- DESIGN TEMPERATURE - MSC
- DESIGN PRESSURE - 6040 kPa

TEST PRESSURE

- MINIMUM - ****kPa
- MAXIMUM - ****kPa
- TEST DATE:_____

ENGINEER:

PRELIMINARY

12.5 0 25 50 75 METRES
25 0 25 50 75 100 125 250 FEET

No.	DATE	BY	APPD	REMARKS
A	2018-01-12	N.C.	D.T.L.	O.E.B. FILING

REVISIONS

uniongas
An Enbridge Company

NPS 20 KINGSVILLE TRANSMISSION REINFORCEMENT PROJECT
2019 CONSTRUCTION - TOWN OF KINGSVILLE
GENERAL LOCATIONS - OEB FILING

DRAWN BY: MATT WADDICK	DATE: 2017-11-22	PLOT SPEC:	1:2000
CHECKED BY:	DATE:	CAD CODE:	PL1876-OEB-05.dgn
APPROVED BY:	DATE:	FILE REVISION DATE:	2018-01-12
SIZE: STRIP	SHEET: N/A	DRAWING No.:	PL1876-OEB-05

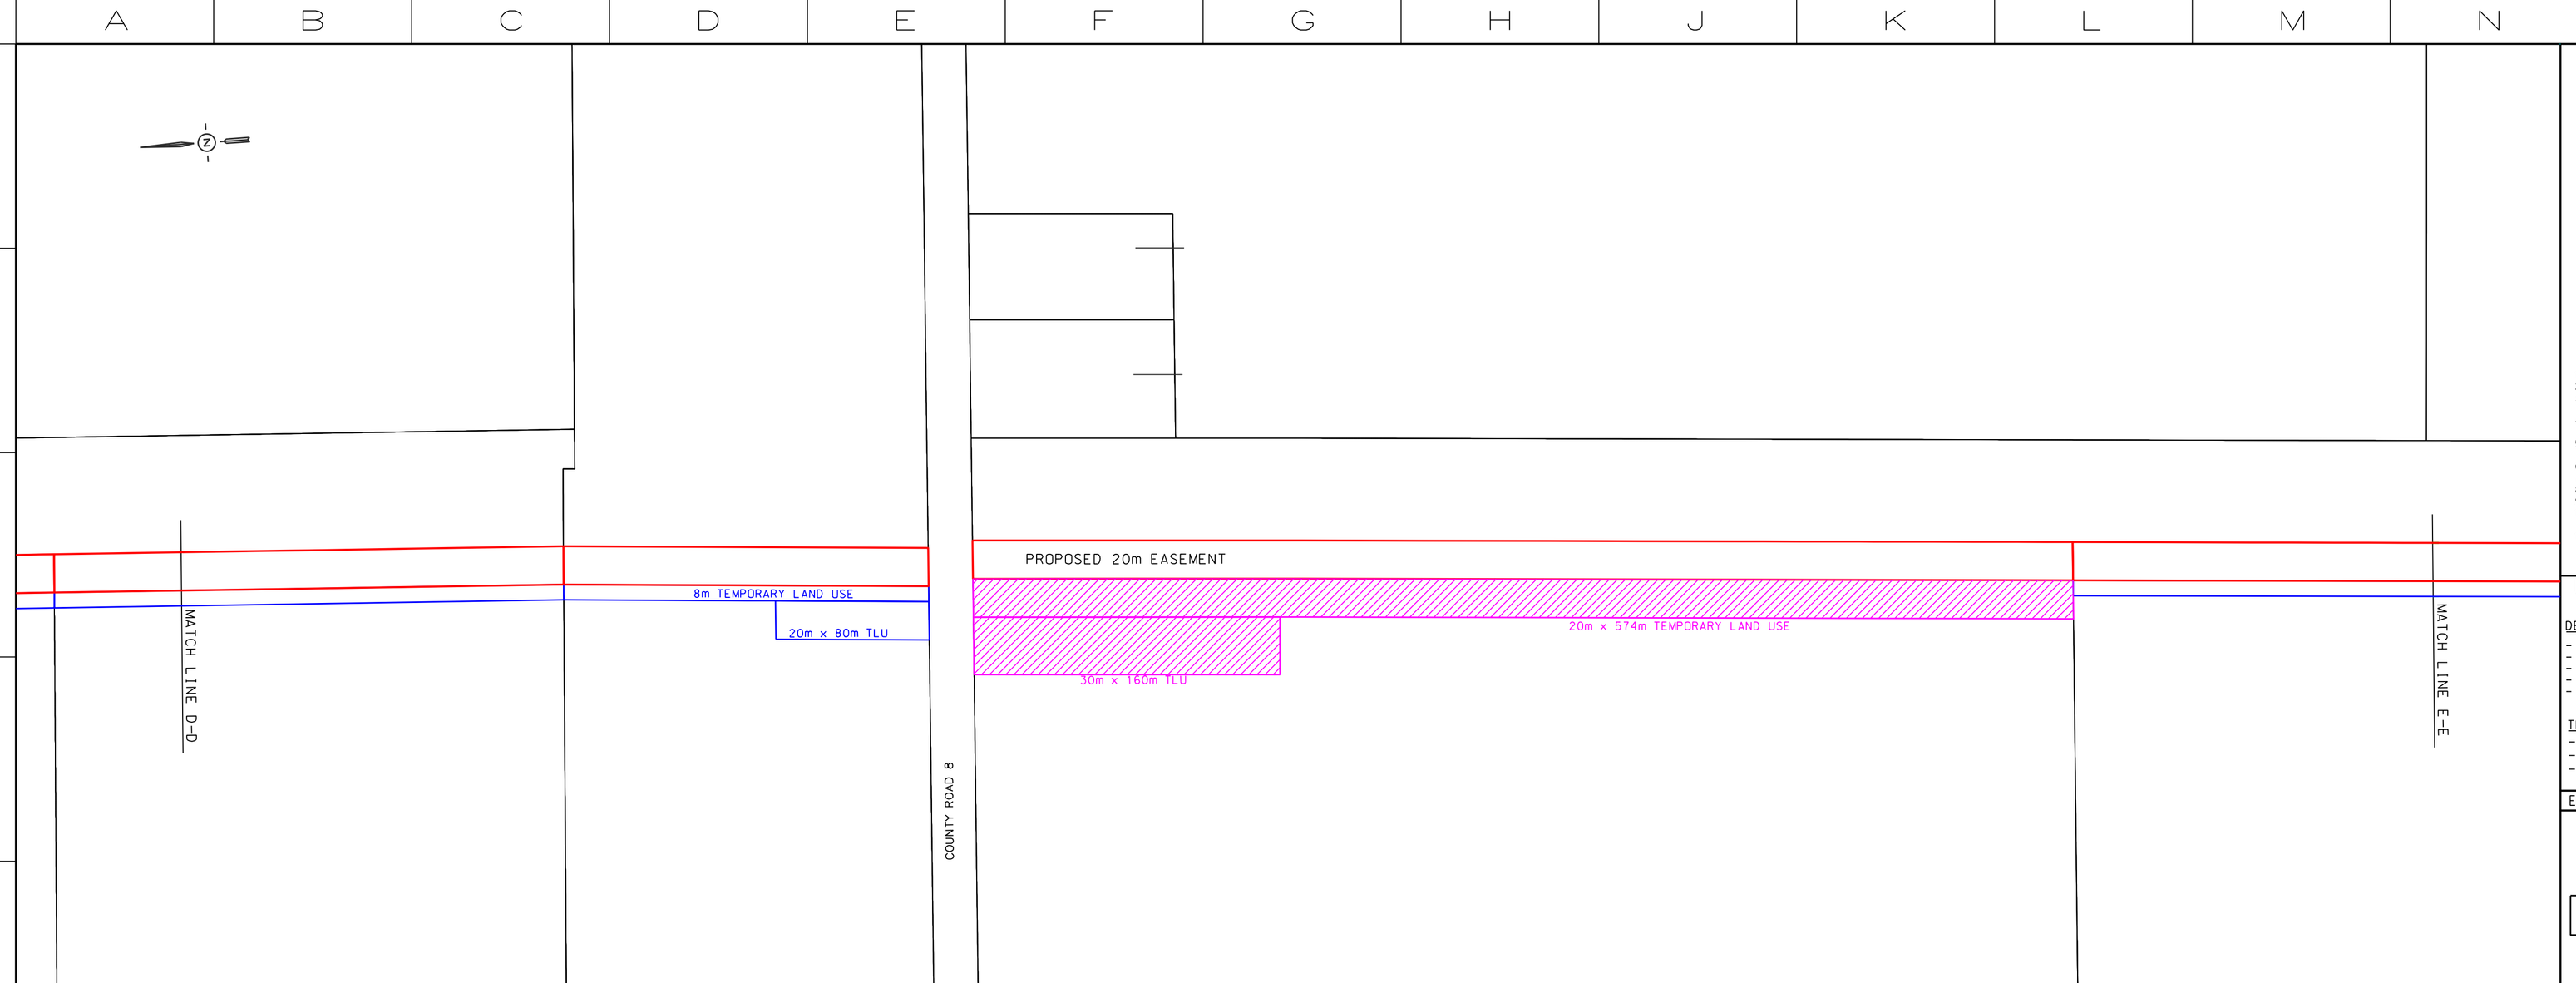

LEGEND

- PROPOSED PIPELINE
- PROPOSED PIPELINE EASEMENT
- TEMPORARY LAND USE
- TEMPORARY LAND USE (NO IMAGERY)
- NEW TEMPORARY LAND USE
- EXISTING PIPELINE EASEMENT
- MOZ AREAS
- WATERCOURSE

CONSTRUCTION NOTES:

1) CONTRACTOR RESPONSIBLE FOR ALL UTILITY LOCATES.
2) DEPTH OF MAIN TO BE 1.2m BELOW ℄ OF ROAD OR DITCH. WHICHEVER IS LOWER.
3) MINIMUM DEPTH OF COVER 1.2m. 1.5m FOR ALL ROAD AND CREEK CROSSINGS AND 3.25m FOR RAILWAY CROSSINGS.
4) MAINTAIN MIN. 500mm CLEARANCE BETWEEN PROPOSED MAIN AND OTHER UTILITIES AND UNDERGROUND STRUCTURES THAT ARE CROSSED.
5) ALL CULVERTS, END WALL TREATMENT AND TILE DRAINS REMOVED DURING CONSTRUCTION ARE TO BE RESTORED TO MATCH EXISTING CONDITIONS.
6) RESTORATION INCLUDES TOPSOIL AND SEEDING.
7) RESTORE DRIVEWAYS TO MATCH EXISTING.
8) ALL ASPHALT AREAS TO BE RESTORED TO MATCH EXISTING.
9) RESTORE ALL OPEN DRAINS TO MATCH ORIGINAL GRADE AND CONTOUR CONDITIONS.
10) ALL WORK MUST BE IN ACCORDANCE WITH THE UNION GAS CONSTRUCTION AND MAINTENANCE MANUAL SPECIFICATIONS.
11) ALL WELDS TO BE NON-DESTRUCTIVELY EXAMINED, AS PER C&M 3.6.8.

DESIGN PARAMETERS

DESIGN

- DESIGNED TO CSA Z662-15
- DESIGN FACTOR - 0.8
- LOCATION FACTOR - **
- DESIGN TEMPERATURE - MSC
- DESIGN PRESSURE - 6040 kPa

TEST PRESSURE

- MINIMUM - ****kPa
- MAXIMUM - ****kPa
- TEST DATE:_____

ENGINEER:

PRELIMINARY

12.5 0 25 50 75 METRES
25 0 25 50 75 100 125 250 FEET

No.	DATE	BY	APPD	REMARKS
B	2018-12-07	M.W.	D.T.L.	O.E.B. FILING 2
A	2018-01-12	N.C.	D.T.L.	O.E.B. FILING

REVISIONS

uniongas
An Enbridge Company

NPS 20 KINGSVILLE TRANSMISSION REINFORCEMENT PROJECT
2019 CONSTRUCTION - TOWN OF KINGSVILLE
GENERAL LOCATIONS - OEB FILING

DRAWN BY: MATT WADDICK	DATE: 2017-11-22	PLOT SPEC:	1:2000
CHECKED BY:	DATE:	CAD CODE:	PL1876-OEB-05.dgn
APPROVED BY:	DATE:	FILE REVISION DATE:	2018-01-12
SIZE: STRIP	SHEET: N/A	DRAWING No.:	PL1876-OEB-05

Filed: 2018-12-19
EB-2018-0013
Schedule 1
Page 6 of 18

TOWN OF KINGSVILLE
COUNTY OF ESSEX

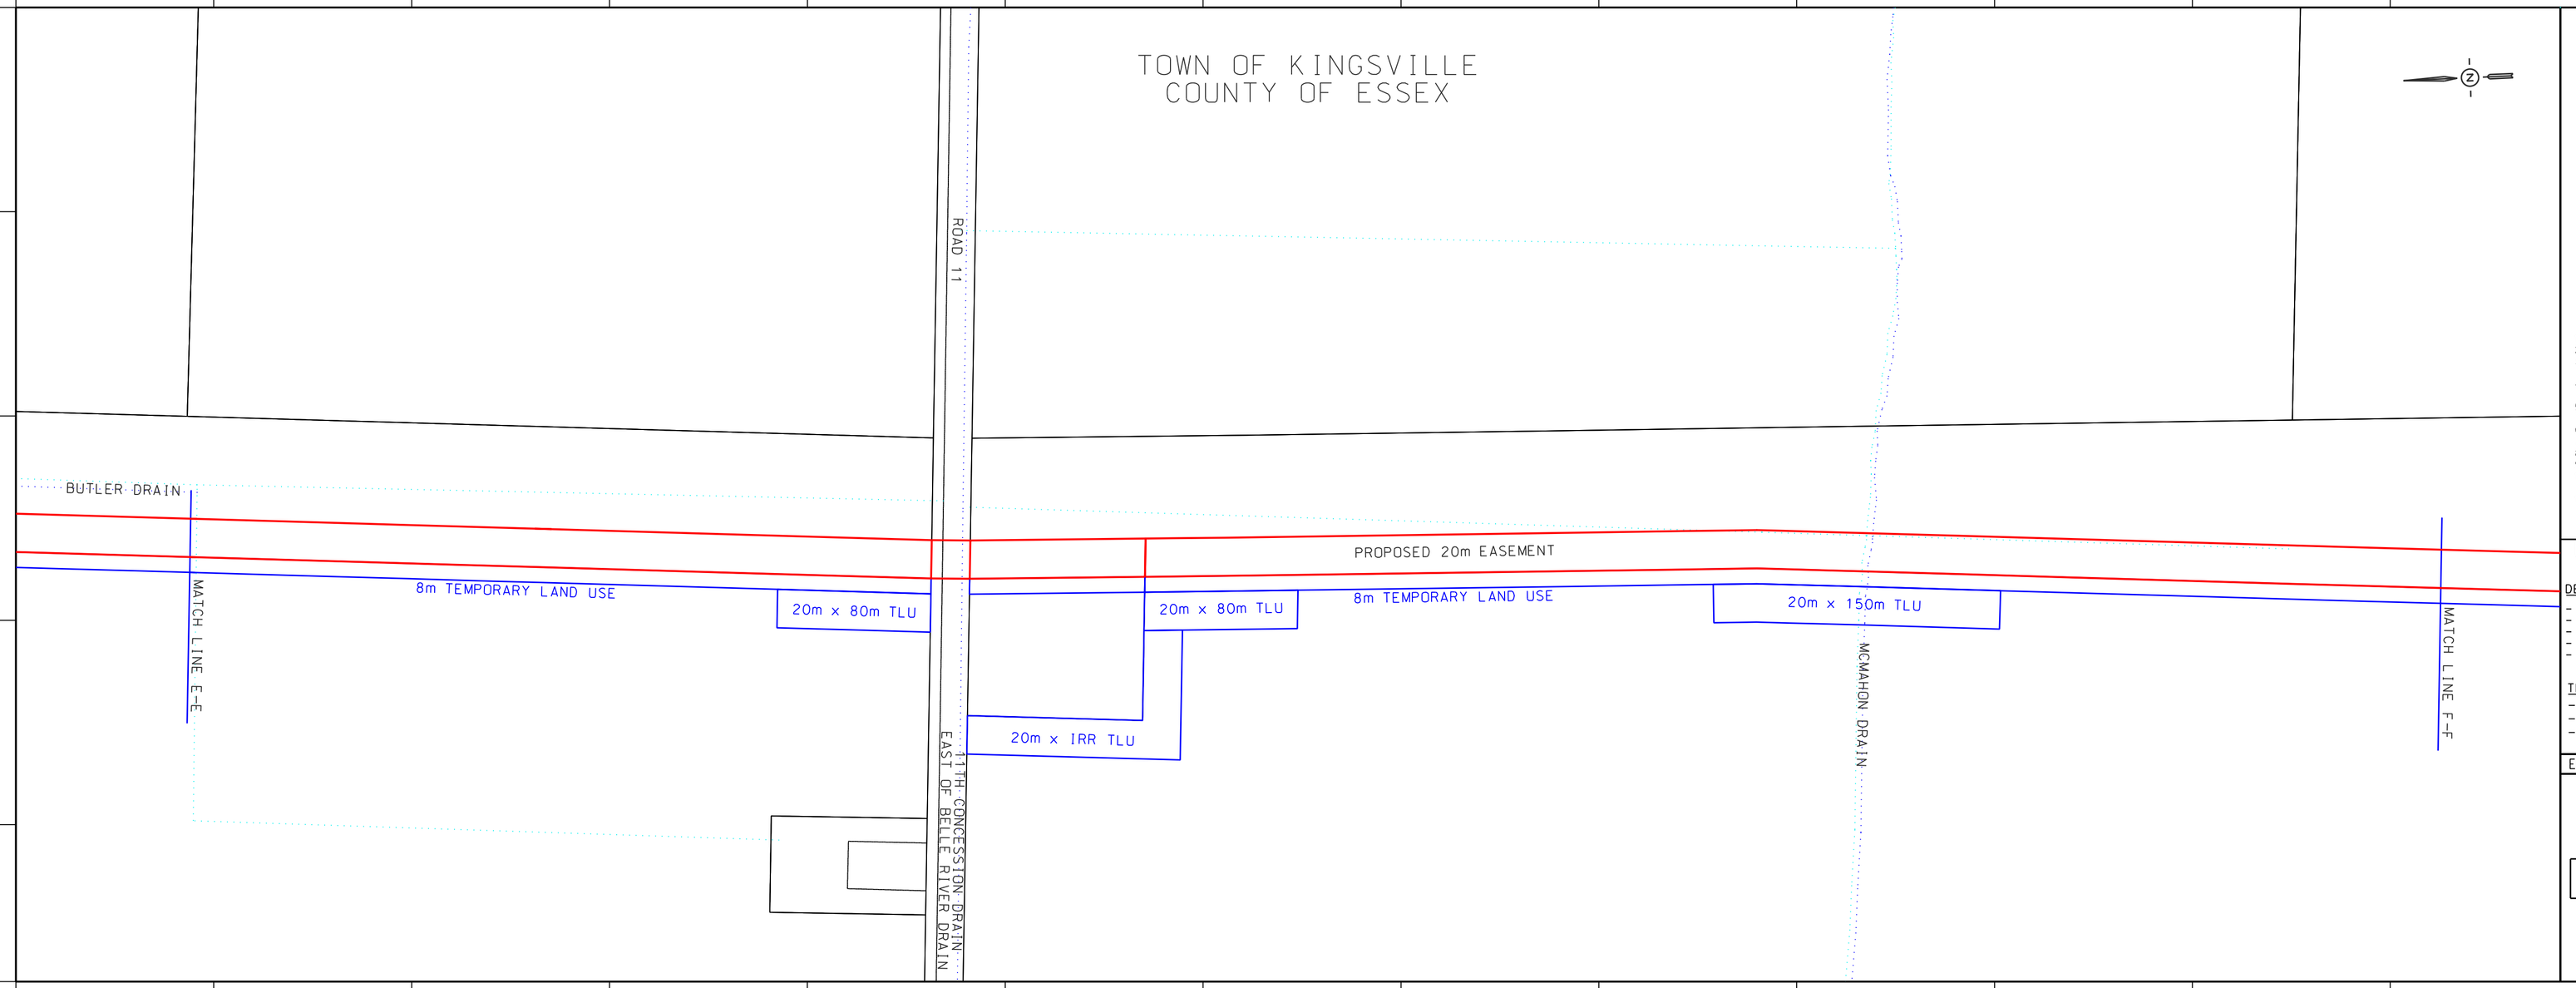

LEGEND

- PROPOSED PIPELINE -
- PROPOSED PIPELINE EASEMENT -
- TEMPORARY LAND USE -
- TEMPORARY LAND USE (NO IMAGERY) -
- NEW TEMPORARY LAND USE -
- EXISTING PIPELINE EASEMENT -
- MOZ AREAS -
- WATERCOURSE -

CONSTRUCTION NOTES:

1) CONTRACTOR RESPONSIBLE FOR ALL UTILITY LOCATES.
2) DEPTH OF MAIN TO BE 1.2m BELOW ℄ OF ROAD OR DITCH. WHICHEVER IS LOWER.
3) MINIMUM DEPTH OF COVER 1.2m. 1.5m FOR ALL ROAD AND CREEK CROSSINGS AND 3.25m FOR RAILWAY CROSSINGS.
4) MAINTAIN MIN. 500mm CLEARANCE BETWEEN PROPOSED MAIN AND OTHER UTILITIES AND UNDERGROUND STRUCTURES THAT ARE CROSSED.
5) ALL CULVERTS, END WALL TREATMENT AND TILE DRAINS REMOVED DURING CONSTRUCTION ARE TO BE RESTORED TO MATCH EXISTING CONDITIONS.
6) RESTORATION INCLUDES TOPSOIL AND SEEDING.
7) RESTORE DRIVEWAYS TO MATCH EXISTING.
8) ALL ASPHALT AREAS TO BE RESTORED TO MATCH EXISTING.
9) RESTORE ALL OPEN DRAINS TO MATCH ORIGINAL GRADE AND CONTOUR CONDITIONS.
10) ALL WORK MUST BE IN ACCORDANCE WITH THE UNION GAS CONSTRUCTION AND MAINTENANCE MANUAL SPECIFICATIONS.
11) ALL WELDS TO BE NON-DESTRUCTIVELY EXAMINED, AS PER C&M 3.6.8.

DESIGN PARAMETERS

DESIGN
- DESIGNED TO CSA Z662-15
- DESIGN FACTOR - 0.8
- LOCATION FACTOR - **
- DESIGN TEMPERATURE - MSC
- DESIGN PRESSURE - 6040 kPa

TEST PRESSURE
- MINIMUM - ****kPa
- MAXIMUM - ****kPa
- TEST DATE:_____

ENGINEER:

PRELIMINARY

12.5 0 25 50 75 METRES
25 0 25 50 75 100 125 250 FEET

No.	DATE	BY	APPD	REMARKS
A	2018-01-12	N.C.	D.T.L.	O.E.B. FILING

REVISIONS

uniongas
An Enbridge Company

NPS 20 KINGSVILLE TRANSMISSION REINFORCEMENT PROJECT
2019 CONSTRUCTION - TOWN OF KINGSVILLE
GENERAL LOCATIONS - OEB FILING

DRAWN BY MATT WADDICK	DATE 2017-11-22	PLOT SPEC:	1:2000
CHECKED BY	DATE	CAD CODE:	PL1876-OEB-06.dgn
APPROVED BY	DATE	FILE REVISION DATE	2018-01-12
SIZE STRIP	SHEET N/A	DRAWING No.	PL1876-OEB-06

TOWN OF KINGSVILLE
COUNTY OF ESSEX

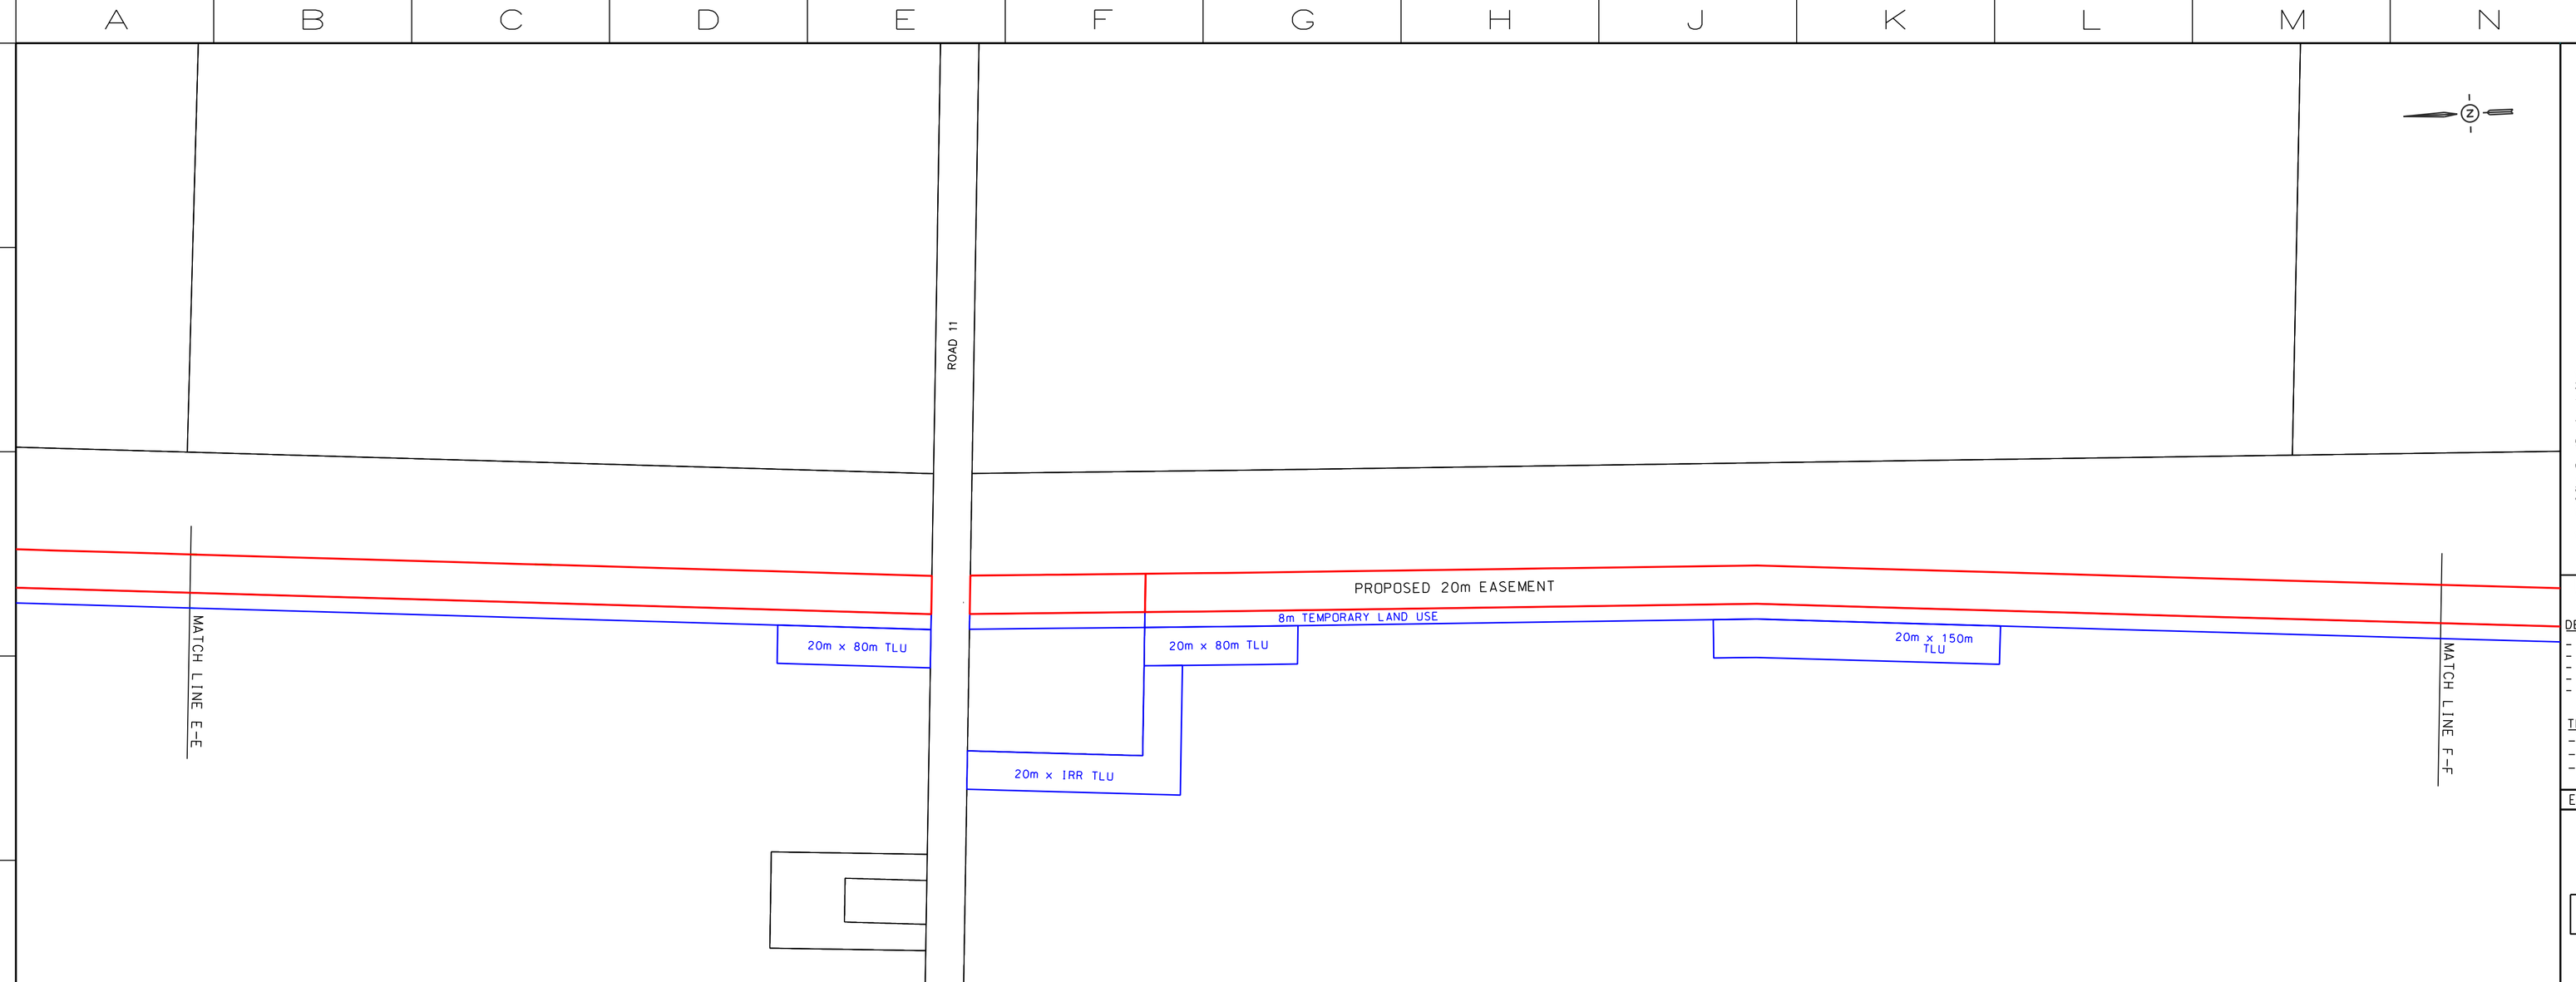

LEGEND
PROPOSED PIPELINE -
PROPOSED PIPELINE EASEMENT -
TEMPORARY LAND USE -
TEMPORARY LAND USE (NO IMAGERY) -
NEW TEMPORARY LAND USE -
EXISTING PIPELINE EASEMENT -
MOZ AREAS -
WATERCOURSE -

CONSTRUCTION NOTES:
1) CONTRACTOR RESPONSIBLE FOR ALL UTILITY LOCATES.
2) DEPTH OF MAIN TO BE 1.2m BELOW ℄ OF ROAD OR DITCH. WHICHEVER IS LOWER.
3) MINIMUM DEPTH OF COVER 1.2m. 1.5m FOR ALL ROAD AND CREEK CROSSINGS AND 3.25m FOR RAILWAY CROSSINGS.
4) MAINTAIN MIN. 500mm CLEARANCE BETWEEN PROPOSED MAIN AND OTHER UTILITIES AND UNDERGROUND STRUCTURES THAT ARE CROSSED.
5) ALL CULVERTS, END WALL TREATMENT AND TILE DRAINS REMOVED DURING CONSTRUCTION ARE TO BE RESTORED TO MATCH EXISTING CONDITIONS.
6) RESTORATION INCLUDES TOPSOIL AND SEEDING.
7) RESTORE DRIVEWAYS TO MATCH EXISTING.
8) ALL ASPHALT AREAS TO BE RESTORED TO MATCH EXISTING.
9) RESTORE ALL OPEN DRAINS TO MATCH ORIGINAL GRADE AND CONTOUR CONDITIONS.
10) ALL WORK MUST BE IN ACCORDANCE WITH THE UNION GAS CONSTRUCTION AND MAINTENANCE MANUAL SPECIFICATIONS.
11) ALL WELDS TO BE NON-DESTRUCTIVELY EXAMINED, AS PER C&M 3.6.8.

DESIGN PARAMETERS
DESIGN
- DESIGNED TO CSA Z662-15
- DESIGN FACTOR - 0.8
- LOCATION FACTOR - **
- DESIGN TEMPERATURE - MSC
- DESIGN PRESSURE - 6040 kPa
TEST PRESSURE
- MINIMUM - ****kPa
- MAXIMUM - ****kPa
- TEST DATE:_____
ENGINEER:
PRELIMINARY

12.5 0 25 50 75 METRES
25 0 25 50 75 100 125 250 FEET

No.	DATE	BY	APPD	REMARKS
B	2018-12-07	M.W.	D.T.L.	O.E.B. FILING 2
A	2018-01-12	N.C.	D.T.L.	O.E.B. FILING

REVISIONS
uniongas
An Enbridge Company
NPS 20 KINGSVILLE TRANSMISSION REINFORCEMENT PROJECT
2019 CONSTRUCTION - TOWN OF KINGSVILLE
GENERAL LOCATIONS - OEB FILING

DRAWN BY MATT WADDICK	DATE 2017-11-22	PLOT SPEC:	1:2000
CHECKED BY	DATE	CAD CODE:	PL1876-OEB-06.dgn
APPROVED BY	DATE	FILE REVISION DATE	2018-12-07
SIZE STRIP	SHEET N/A	DRAWING No.	PL1876-OEB-06

Filed: 2018-12-19
EB-2018-0013
Schedule 2 Change Request 1
Redacted
Page 6 of 18

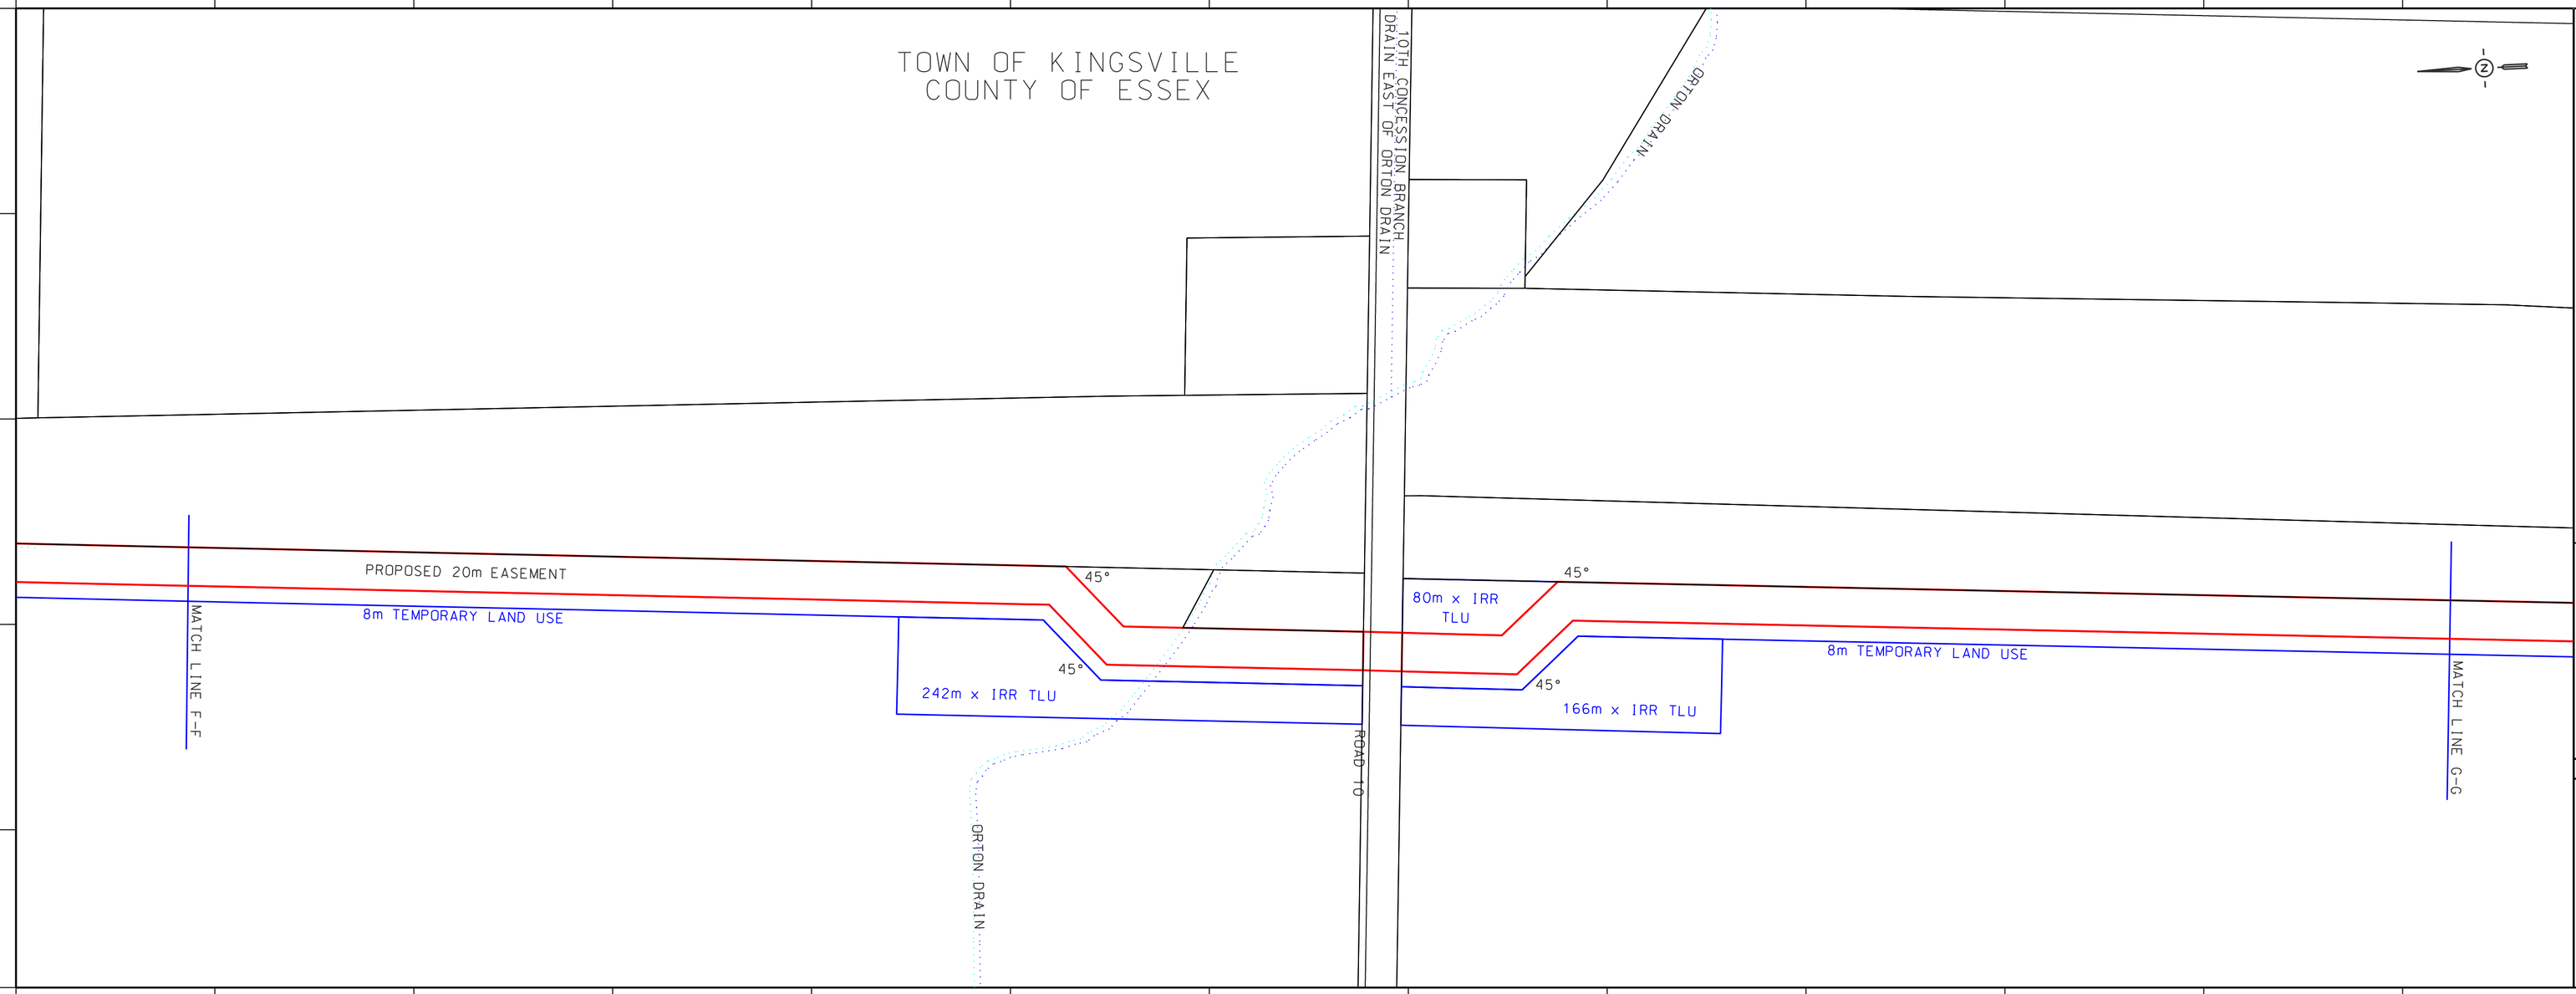

LEGEND

- PROPOSED PIPELINE -
- PROPOSED PIPELINE EASEMENT -
- TEMPORARY LAND USE -
- TEMPORARY LAND USE (NO IMAGERY) -
- NEW TEMPORARY LAND USE -
- EXISTING PIPELINE EASEMENT -
- MOZ AREAS -
- WATERCOURSE -

CONSTRUCTION NOTES:

1) CONTRACTOR RESPONSIBLE FOR ALL UTILITY LOCATES.
2) DEPTH OF MAIN TO BE 1.2m BELOW ℄ OF ROAD OR DITCH. WHICHEVER IS LOWER.
3) MINIMUM DEPTH OF COVER 1.2m. 1.5m FOR ALL ROAD AND CREEK CROSSINGS AND 3.25m FOR RAILWAY CROSSINGS.
4) MAINTAIN MIN. 500mm CLEARANCE BETWEEN PROPOSED MAIN AND OTHER UTILITIES AND UNDERGROUND STRUCTURES THAT ARE CROSSED.
5) ALL CULVERTS, END WALL TREATMENT AND TILE DRAINS REMOVED DURING CONSTRUCTION ARE TO BE RESTORED TO MATCH EXISTING CONDITIONS.
6) RESTORATION INCLUDES TOPSOIL AND SEEDING.
7) RESTORE DRIVEWAYS TO MATCH EXISTING.
8) ALL ASPHALT AREAS TO BE RESTORED TO MATCH EXISTING.
9) RESTORE ALL OPEN DRAINS TO MATCH ORIGINAL GRADE AND CONTOUR CONDITIONS.
10) ALL WORK MUST BE IN ACCORDANCE WITH THE UNION GAS CONSTRUCTION AND MAINTENANCE MANUAL SPECIFICATIONS.
11) ALL WELDS TO BE NON-DESTRUCTIVELY EXAMINED, AS PER C&M 3.6.8.

DESIGN PARAMETERS

DESIGN

- DESIGNED TO CSA Z662-15
- DESIGN FACTOR - 0.8
- LOCATION FACTOR - **
- DESIGN TEMPERATURE - MSC
- DESIGN PRESSURE - 6040 kPa

TEST PRESSURE

- MINIMUM - ****kPa
- MAXIMUM - ****kPa
- TEST DATE:_____

ENGINEER:

PRELIMINARY

12.5 0 25 50 75 METRES
25 0 25 50 75 100 125 250 FEET

No.	DATE	BY	APPD	REMARKS
A	2018-01-12	N.C.	D.T.L.	OEB FILING

REVISIONS

uniongas
An Enbridge Company

NPS 20 KINGSVILLE TRANSMISSION REINFORCEMENT PROJECT
2019 CONSTRUCTION - TOWN OF KINGSVILLE
GENERAL LOCATIONS - OEB FILING

DRAWN BY MATT WADDICK	DATE 2017-11-22	PLOT SPEC:	1:2000
CHECKED BY	DATE	CAD CODE:	PL1876-OEB-07.dgn
APPROVED BY	DATE	FILE REVISION DATE	2018-01-12

SIZE	SHEET	DRAWING No.
STRIP	N/A	PL1876-OEB-07

LEGEND

- PROPOSED PIPELINE -
- PROPOSED PIPELINE EASEMENT -
- TEMPORARY LAND USE -
- TEMPORARY LAND USE (NO IMAGERY) -
- NEW TEMPORARY LAND USE -
- EXISTING PIPELINE EASEMENT -
- MOZ AREAS -
- WATERCOURSE -

CONSTRUCTION NOTES:

1) CONTRACTOR RESPONSIBLE FOR ALL UTILITY LOCATES.
2) DEPTH OF MAIN TO BE 1.2m BELOW ℄ OF ROAD OR DITCH. WHICHEVER IS LOWER.
3) MINIMUM DEPTH OF COVER 1.2m. 1.5m FOR ALL ROAD AND CREEK CROSSINGS AND 3.25m FOR RAILWAY CROSSINGS.
4) MAINTAIN MIN. 500mm CLEARANCE BETWEEN PROPOSED MAIN AND OTHER UTILITIES AND UNDERGROUND STRUCTURES THAT ARE CROSSED.
5) ALL CULVERTS, END WALL TREATMENT AND TILE DRAINS REMOVED DURING CONSTRUCTION ARE TO BE RESTORED TO MATCH EXISTING CONDITIONS.
6) RESTORATION INCLUDES TOPSOIL AND SEEDING.
7) RESTORE DRIVEWAYS TO MATCH EXISTING.
8) ALL ASPHALT AREAS TO BE RESTORED TO MATCH EXISTING.
9) RESTORE ALL OPEN DRAINS TO MATCH ORIGINAL GRADE AND CONTOUR CONDITIONS.
10) ALL WORK MUST BE IN ACCORDANCE WITH THE UNION GAS CONSTRUCTION AND MAINTENANCE MANUAL SPECIFICATIONS.
11) ALL WELDS TO BE NON-DESTRUCTIVELY EXAMINED, AS PER C&M 3.6.8.

DESIGN PARAMETERS

DESIGN

- DESIGNED TO CSA Z662-15
- DESIGN FACTOR - 0.8
- LOCATION FACTOR - **
- DESIGN TEMPERATURE - MSC
- DESIGN PRESSURE - 6040 kPa

TEST PRESSURE

- MINIMUM - ****kPa
- MAXIMUM - ****kPa
- TEST DATE:_____

ENGINEER:

PRELIMINARY

12.5 0 25 50 75 METRES
25 0 25 50 75 100 125 250 FEET

No.	DATE	BY	APPD	REMARKS
B	2018-12-07	M.W.	D.T.L.	OEB FILING 2
A	2018-01-12	N.C.	D.T.L.	OEB FILING

REVISIONS

uniongas
An Enbridge Company

NPS 20 KINGSVILLE TRANSMISSION REINFORCEMENT PROJECT
2019 CONSTRUCTION - TOWN OF KINGSVILLE
GENERAL LOCATIONS - OEB FILING

DRAWN BY MATT WADDICK	DATE 2017-11-22	PLOT SPEC:	1:2000
CHECKED BY	DATE	CAD CODE:	PL1876-OEB-07.dgn
APPROVED BY	DATE	FILE REVISION DATE	2018-12-07

SIZE	SHEET	DRAWING No.
STRIP	N/A	PL1876-OEB-07

Filed: 2018-12-19
EB-2018-0013
Schedule 2 Redacted
Page 2 of 18
Change Request 1

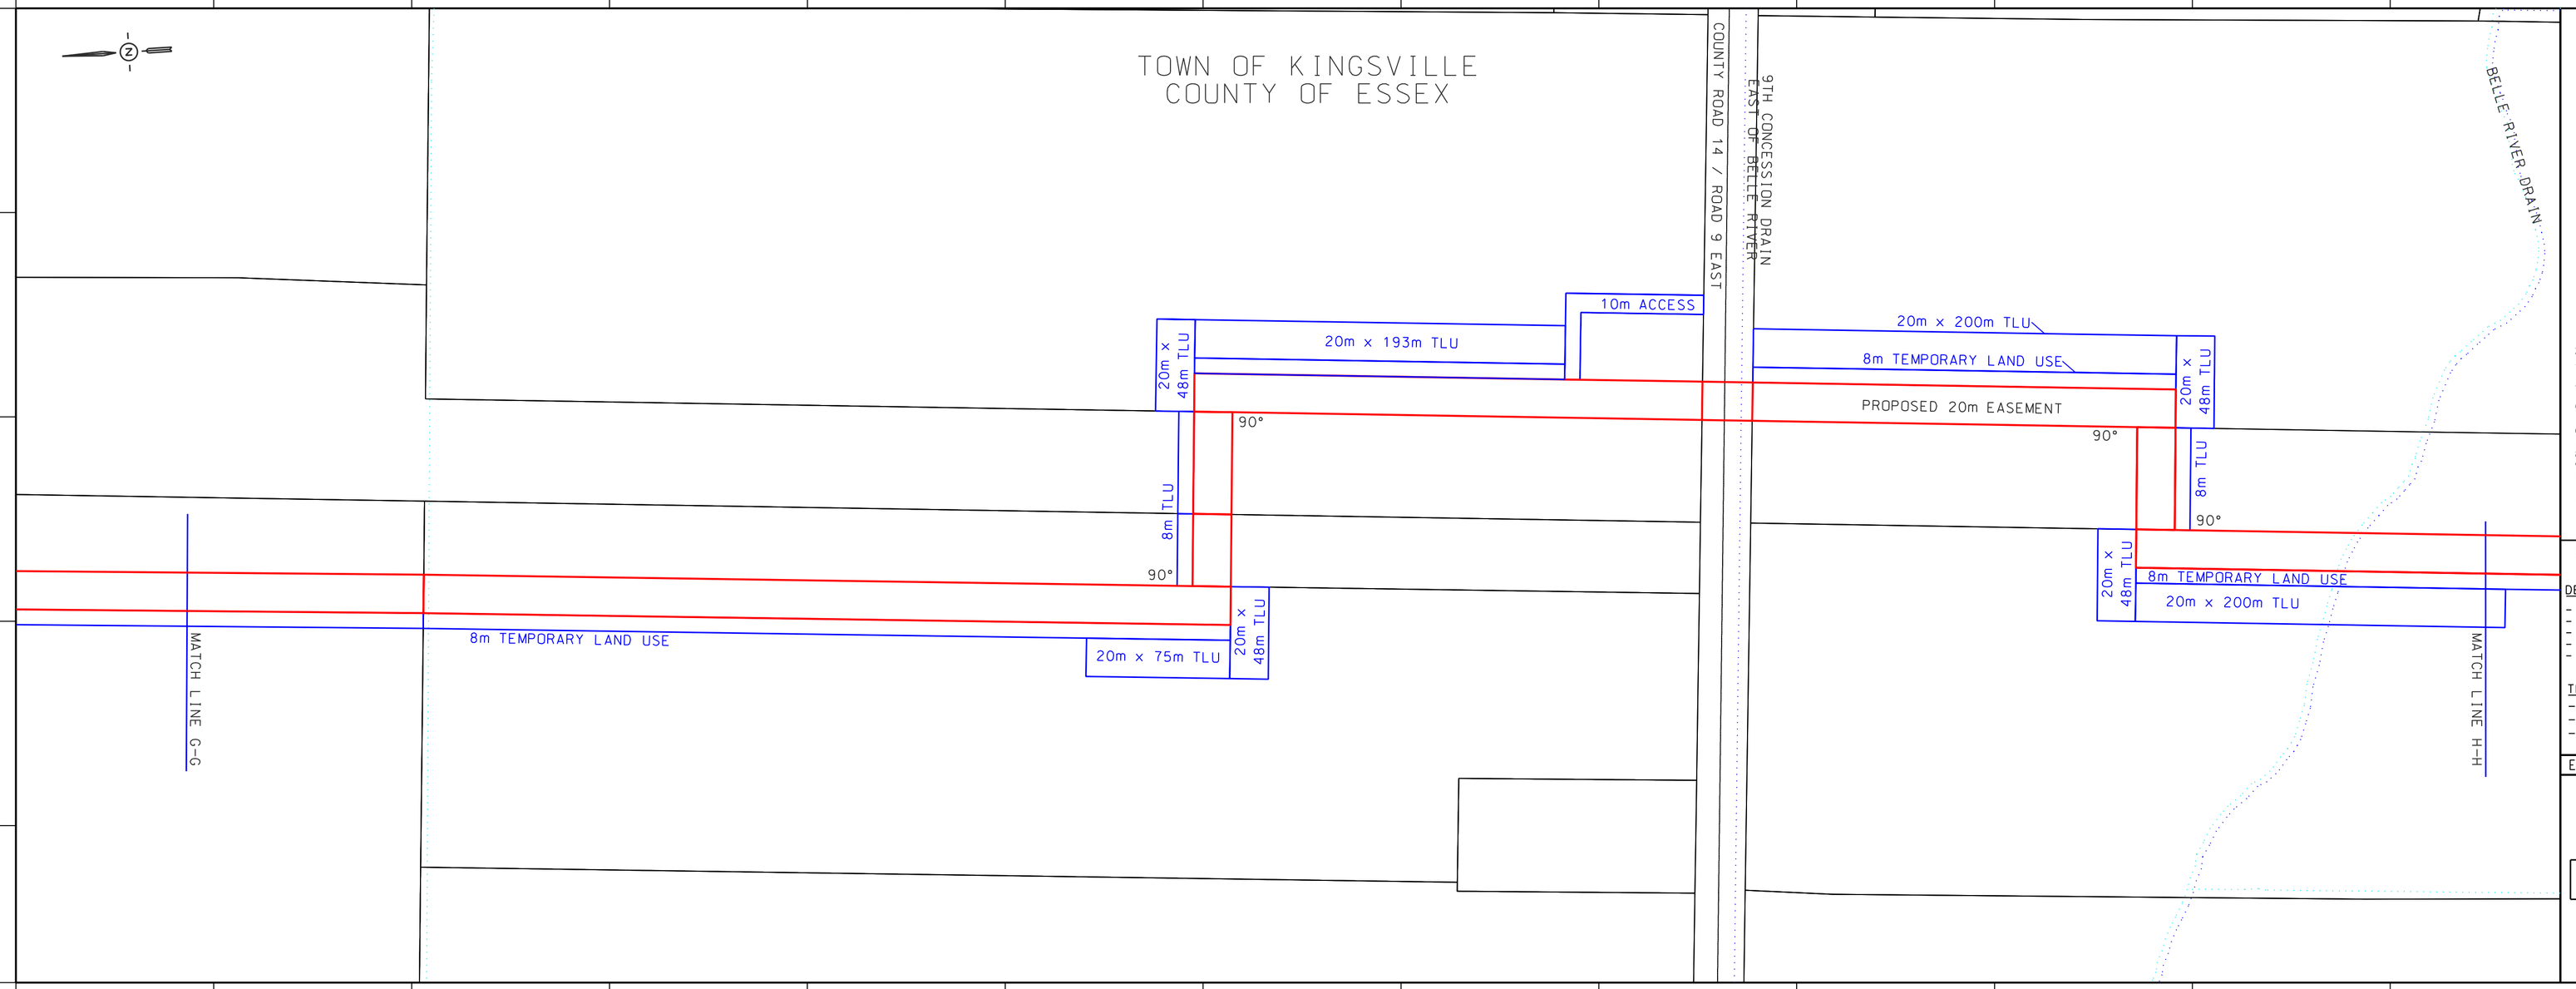

LEGEND

- PROPOSED PIPELINE -
- PROPOSED PIPELINE EASEMENT -
- TEMPORARY LAND USE -
- TEMPORARY LAND USE (NO IMAGERY) -
- NEW TEMPORARY LAND USE -
- EXISTING PIPELINE EASEMENT -
- MOZ AREAS -
- WATERCOURSE -

CONSTRUCTION NOTES:

1) CONTRACTOR RESPONSIBLE FOR ALL UTILITY LOCATES.
2) DEPTH OF MAIN TO BE 1.2m BELOW ℄ OF ROAD OR DITCH. WHICHEVER IS LOWER.
3) MINIMUM DEPTH OF COVER 1.2m. 1.5m FOR ALL ROAD AND CREEK CROSSINGS AND 3.25m FOR RAILWAY CROSSINGS.
4) MAINTAIN MIN. 500mm CLEARANCE BETWEEN PROPOSED MAIN AND OTHER UTILITIES AND UNDERGROUND STRUCTURES THAT ARE CROSSED.
5) ALL CULVERTS, END WALL TREATMENT AND TILE DRAINS REMOVED DURING CONSTRUCTION ARE TO BE RESTORED TO MATCH EXISTING CONDITIONS.
6) RESTORATION INCLUDES TOPSOIL AND SEEDING.
7) RESTORE DRIVEWAYS TO MATCH EXISTING.
8) ALL ASPHALT AREAS TO BE RESTORED TO MATCH EXISTING.
9) RESTORE ALL OPEN DRAINS TO MATCH ORIGINAL GRADE AND CONTOUR CONDITIONS.
10) ALL WORK MUST BE IN ACCORDANCE WITH THE UNION GAS CONSTRUCTION AND MAINTENANCE MANUAL SPECIFICATIONS.
11) ALL WELDS TO BE NON-DESTRUCTIVELY EXAMINED, AS PER C&M 3.6.8.

DESIGN PARAMETERS

DESIGN

- DESIGNED TO CSA Z662-15
- DESIGN FACTOR - 0.8
- LOCATION FACTOR - **
- DESIGN TEMPERATURE - MSC
- DESIGN PRESSURE - 6040 kPa

TEST PRESSURE

- MINIMUM - ****kPa
- MAXIMUM - ****kPa
- TEST DATE:_____

ENGINEER:

PRELIMINARY

12.5 0 25 50 75 METRES
25 0 25 50 75 100 125 250 FEET

No.	DATE	BY	APPD	REMARKS
A	2018-01-12	N.C.	D.T.L.	OEB FILING

REVISIONS

uniongas
An Enbridge Company

NPS 20 KINGSVILLE TRANSMISSION REINFORCEMENT PROJECT
2019 CONSTRUCTION - TOWN OF KINGSVILLE
GENERAL LOCATIONS - OEB FILING

DRAWN BY: MATT WADDICK	DATE: 2017-11-22	PLOT SPEC:	1:2000
CHECKED BY:	DATE:	CAD CODE:	PL1876-OEB-08.dgn
APPROVED BY:	DATE:	FILE REVISION DATE:	2018-01-12
SIZE: STRIP	SHEET: N/A	DRAWING No.:	PL1876-OEB-08

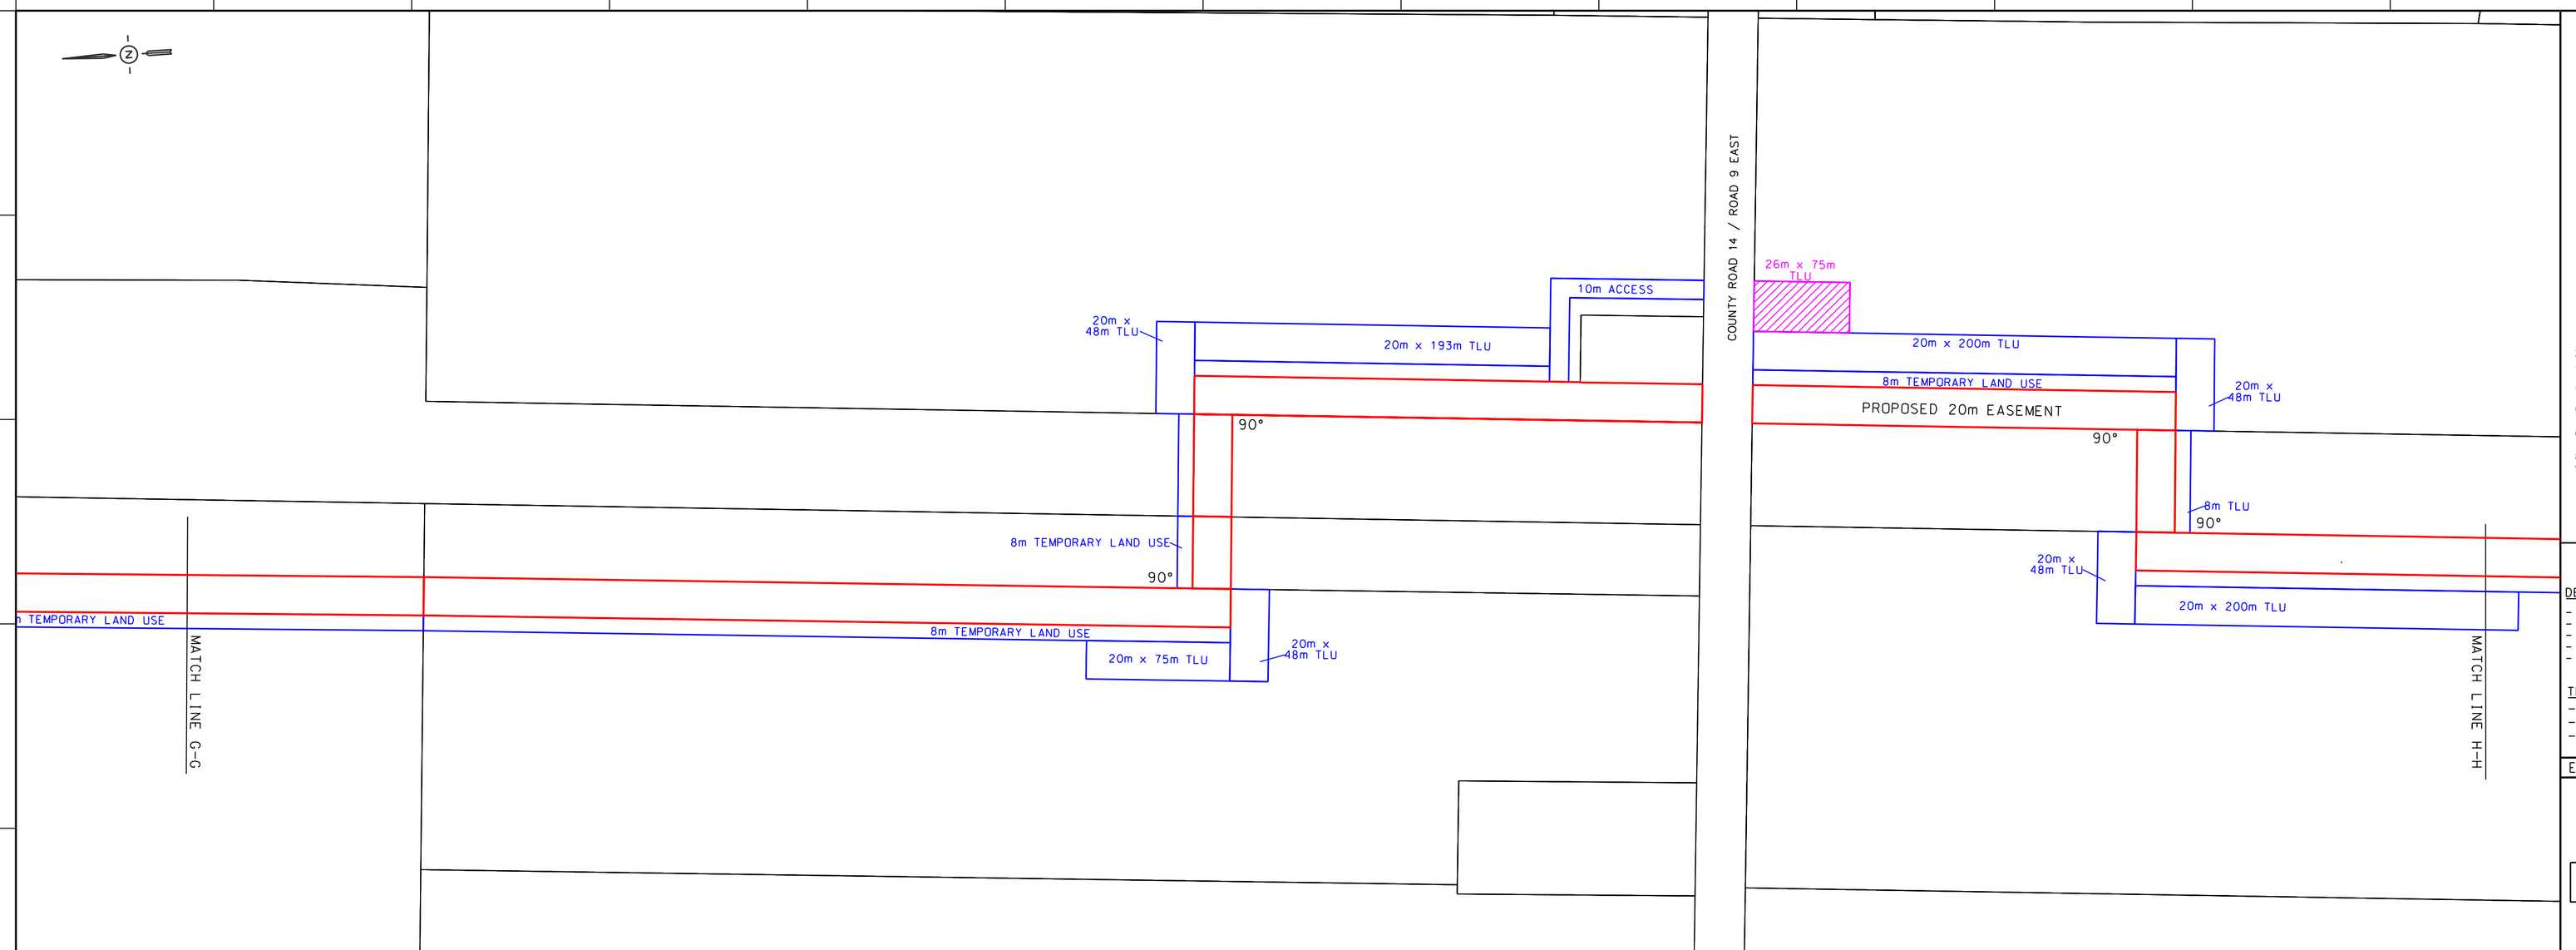

LEGEND

- PROPOSED PIPELINE -
- PROPOSED PIPELINE EASEMENT -
- TEMPORARY LAND USE -
- TEMPORARY LAND USE (NO IMAGERY) -
- NEW TEMPORARY LAND USE -
- EXISTING PIPELINE EASEMENT -
- MOZ AREAS -
- WATERCOURSE -

CONSTRUCTION NOTES:

1) CONTRACTOR RESPONSIBLE FOR ALL UTILITY LOCATES.
2) DEPTH OF MAIN TO BE 1.2m BELOW ℄ OF ROAD OR DITCH. WHICHEVER IS LOWER.
3) MINIMUM DEPTH OF COVER 1.2m. 1.5m FOR ALL ROAD AND CREEK CROSSINGS AND 3.25m FOR RAILWAY CROSSINGS.
4) MAINTAIN MIN. 500mm CLEARANCE BETWEEN PROPOSED MAIN AND OTHER UTILITIES AND UNDERGROUND STRUCTURES THAT ARE CROSSED.
5) ALL CULVERTS, END WALL TREATMENT AND TILE DRAINS REMOVED DURING CONSTRUCTION ARE TO BE RESTORED TO MATCH EXISTING CONDITIONS.
6) RESTORATION INCLUDES TOPSOIL AND SEEDING.
7) RESTORE DRIVEWAYS TO MATCH EXISTING.
8) ALL ASPHALT AREAS TO BE RESTORED TO MATCH EXISTING.
9) RESTORE ALL OPEN DRAINS TO MATCH ORIGINAL GRADE AND CONTOUR CONDITIONS.
10) ALL WORK MUST BE IN ACCORDANCE WITH THE UNION GAS CONSTRUCTION AND MAINTENANCE MANUAL SPECIFICATIONS.
11) ALL WELDS TO BE NON-DESTRUCTIVELY EXAMINED, AS PER C&M 3.6.8.

DESIGN PARAMETERS

DESIGN

- DESIGNED TO CSA Z662-15
- DESIGN FACTOR - 0.8
- LOCATION FACTOR - **
- DESIGN TEMPERATURE - MSC
- DESIGN PRESSURE - 6040 kPa

TEST PRESSURE

- MINIMUM - ****kPa
- MAXIMUM - ****kPa
- TEST DATE:_____

ENGINEER:

PRELIMINARY

12.5 0 25 50 75 METRES
25 0 25 50 75 100 125 250 FEET

No.	DATE	BY	APPD	REMARKS
B	2018-12-07	M.W.	D.T.L.	OEB FILING 2
A	2018-01-12	N.C.	D.T.L.	OEB FILING

REVISIONS

uniongas
An Enbridge Company

NPS 20 KINGSVILLE TRANSMISSION REINFORCEMENT PROJECT
2019 CONSTRUCTION - TOWN OF KINGSVILLE
GENERAL LOCATIONS - OEB FILING

DRAWN BY: MATT WADDICK	DATE: 2017-11-22	PLOT SPEC:	1:2000
CHECKED BY:	DATE:	CAD CODE:	PL1876-OEB-08.dgn
APPROVED BY:	DATE:	FILE REVISION DATE:	2018-01-12
SIZE: STRIP	SHEET: N/A	DRAWING No.:	PL1876-OEB-08

Filed: 2018-12-19
EB-2018-0013
Schedule 2
Change Request 1
Redacted
Page 2 of 18

TOWN OF KINGSVILLE
COUNTY OF ESSEX

BELLE RIVER DRAIN

PROPOSED 20m EASEMENT

LAND USE
TLU

8m TEMPORARY LAND USE

20m x 80m TLU

MATCH LINE H-H

ROAD 8 EAST

20m x 80m TLU

MATCH LINE 1-1

MADDOX DRAIN

LEGEND

PROPOSED PIPELINE	-	
PROPOSED PIPELINE EASEMENT	-	
TEMPORARY LAND USE	-	
TEMPORARY LAND USE (NO IMAGERY)	-	
NEW TEMPORARY LAND USE	-	
EXISTING PIPELINE EASEMENT	-	
MOZ AREAS	-	
WATERCOURSE	-	

CONSTRUCTION NOTES:

1) CONTRACTOR RESPONSIBLE FOR ALL UTILITY LOCATES.
2) DEPTH OF MAIN TO BE 1.2m BELOW ℄ OF ROAD OR DITCH. WHICHEVER IS LOWER.
3) MINIMUM DEPTH OF COVER 1.2m. 1.5m FOR ALL ROAD AND CREEK CROSSINGS AND 3.25m FOR RAILWAY CROSSINGS.
4) MAINTAIN MIN. 500mm CLEARANCE BETWEEN PROPOSED MAIN AND OTHER UTILITIES AND UNDERGROUND STRUCTURES THAT ARE CROSSED.
5) ALL CULVERTS, END WALL TREATMENT AND TILE DRAINS REMOVED DURING CONSTRUCTION ARE TO BE RESTORED TO MATCH EXISTING CONDITIONS.
6) RESTORATION INCLUDES TOPSOIL AND SEEDING.
7) RESTORE DRIVEWAYS TO MATCH EXISTING.
8) ALL ASPHALT AREAS TO BE RESTORED TO MATCH EXISTING.
9) RESTORE ALL OPEN DRAINS TO MATCH ORIGINAL GRADE AND CONTOUR CONDITIONS.
10) ALL WORK MUST BE IN ACCORDANCE WITH THE UNION GAS CONSTRUCTION AND MAINTENANCE MANUAL SPECIFICATIONS.
11) ALL WELDS TO BE NON-DESTRUCTIVELY EXAMINED, AS PER C&M 3.6.8.

DESIGN PARAMETERS

DESIGN
- DESIGNED TO CSA Z662-15
- DESIGN FACTOR - 0.8
- LOCATION FACTOR - **
- DESIGN TEMPERATURE - MSC
- DESIGN PRESSURE - 6040 kPa

TEST PRESSURE
- MINIMUM - ****kPa
- MAXIMUM - ****kPa
- TEST DATE:_____

ENGINEER:

PRELIMINARY

12.5 0 25 50 75 METRES
25 0 25 50 75 100 125 250 FEET

No.	DATE	BY	APPD	REMARKS
A	2018-01-12	N.C.	D.T.L.	O.E.B. FILING

REVISIONS

uniongas
An Enbridge Company

NPS 20 KINGSVILLE TRANSMISSION REINFORCEMENT PROJECT
2019 CONSTRUCTION - TOWN OF KINGSVILLE
GENERAL LOCATIONS - OEB FILING

DRAWN BY: MATT WADDICK	DATE: 2017-11-22	PLOT SPEC:	1:2000
CHECKED BY:	DATE:	CAD CODE:	PL1876-OEB-09.dgn
APPROVED BY:	DATE:	FILE REVISION DATE:	2018-01-12
SIZE: STRIP	SHEET: N/A	DRAWING No.:	PL1876-OEB-09

TOWN OF KINGSVILLE
COUNTY OF ESSEX

PROPOSED 20m EASEMENT

TLU

8m TEMPORARY LAND USE

20m x 80m TLU

MATCH LINE H-H

ROAD 8 EAST

20m x 80m TLU

MATCH LINE 1-1

NORTH

LEGEND

CONSTRUCTION NOTES:

1) CONTRACTOR RESPONSIBLE FOR ALL UTILITY LOCATES.
2) DEPTH OF MAIN TO BE 1.2m BELOW ℄ OF ROAD OR DITCH. WHICHEVER IS LOWER.
3) MINIMUM DEPTH OF COVER 1.2m. 1.5m FOR ALL ROAD AND CREEK CROSSINGS AND 3.25m FOR RAILWAY CROSSINGS.
4) MAINTAIN MIN. 500mm CLEARANCE BETWEEN PROPOSED MAIN AND OTHER UTILITIES AND UNDERGROUND STRUCTURES THAT ARE CROSSED.
5) ALL CULVERTS, END WALL TREATMENT AND TILE DRAINS REMOVED DURING CONSTRUCTION ARE TO BE RESTORED TO MATCH EXISTING CONDITIONS.
6) RESTORATION INCLUDES TOPSOIL AND SEEDING.
7) RESTORE DRIVEWAYS TO MATCH EXISTING.
8) ALL ASPHALT AREAS TO BE RESTORED TO MATCH EXISTING.
9) RESTORE ALL OPEN DRAINS TO MATCH ORIGINAL GRADE AND CONTOUR CONDITIONS.
10) ALL WORK MUST BE IN ACCORDANCE WITH THE UNION GAS CONSTRUCTION AND MAINTENANCE MANUAL SPECIFICATIONS.
11) ALL WELDS TO BE NON-DESTRUCTIVELY EXAMINED, AS PER C&M 3.6.8.

DESIGN PARAMETERS

DESIGN
- DESIGNED TO CSA Z662-15
- DESIGN FACTOR - 0.8
- LOCATION FACTOR - **
- DESIGN TEMPERATURE - MSC
- DESIGN PRESSURE - 6040 kPa

TEST PRESSURE
- MINIMUM - ****kPa
- MAXIMUM - ****kPa
- TEST DATE:_____

ENGINEER:

PRELIMINARY

12.5 0 25 50 75 METRES
25 0 25 50 75 100 125 250 FEET

No.	DATE	BY	APPD	REMARKS
B	2018-12-07	M.W.	D.T.L.	O.E.B. FILING 2
A	2018-01-12	N.C.	D.T.L.	O.E.B. FILING

REVISIONS

uniongas
An Enbridge Company

NPS 20 KINGSVILLE TRANSMISSION REINFORCEMENT PROJECT
2019 CONSTRUCTION - TOWN OF KINGSVILLE
GENERAL LOCATIONS - OEB FILING

DRAWN BY: MATT WADDICK	DATE: 2017-11-22	PLOT SPEC:	1:2000
CHECKED BY:	DATE:	CAD CODE:	PL1876-OEB-09.dgn
APPROVED BY:	DATE:	FILE REVISION DATE:	2018-12-07
SIZE: STRIP	SHEET: N/A	DRAWING No.:	PL1876-OEB-09

Filed: 2018-12-19
EB-2018-0013
Schedule 1
Change Request
Redacted
Page 6 of 18

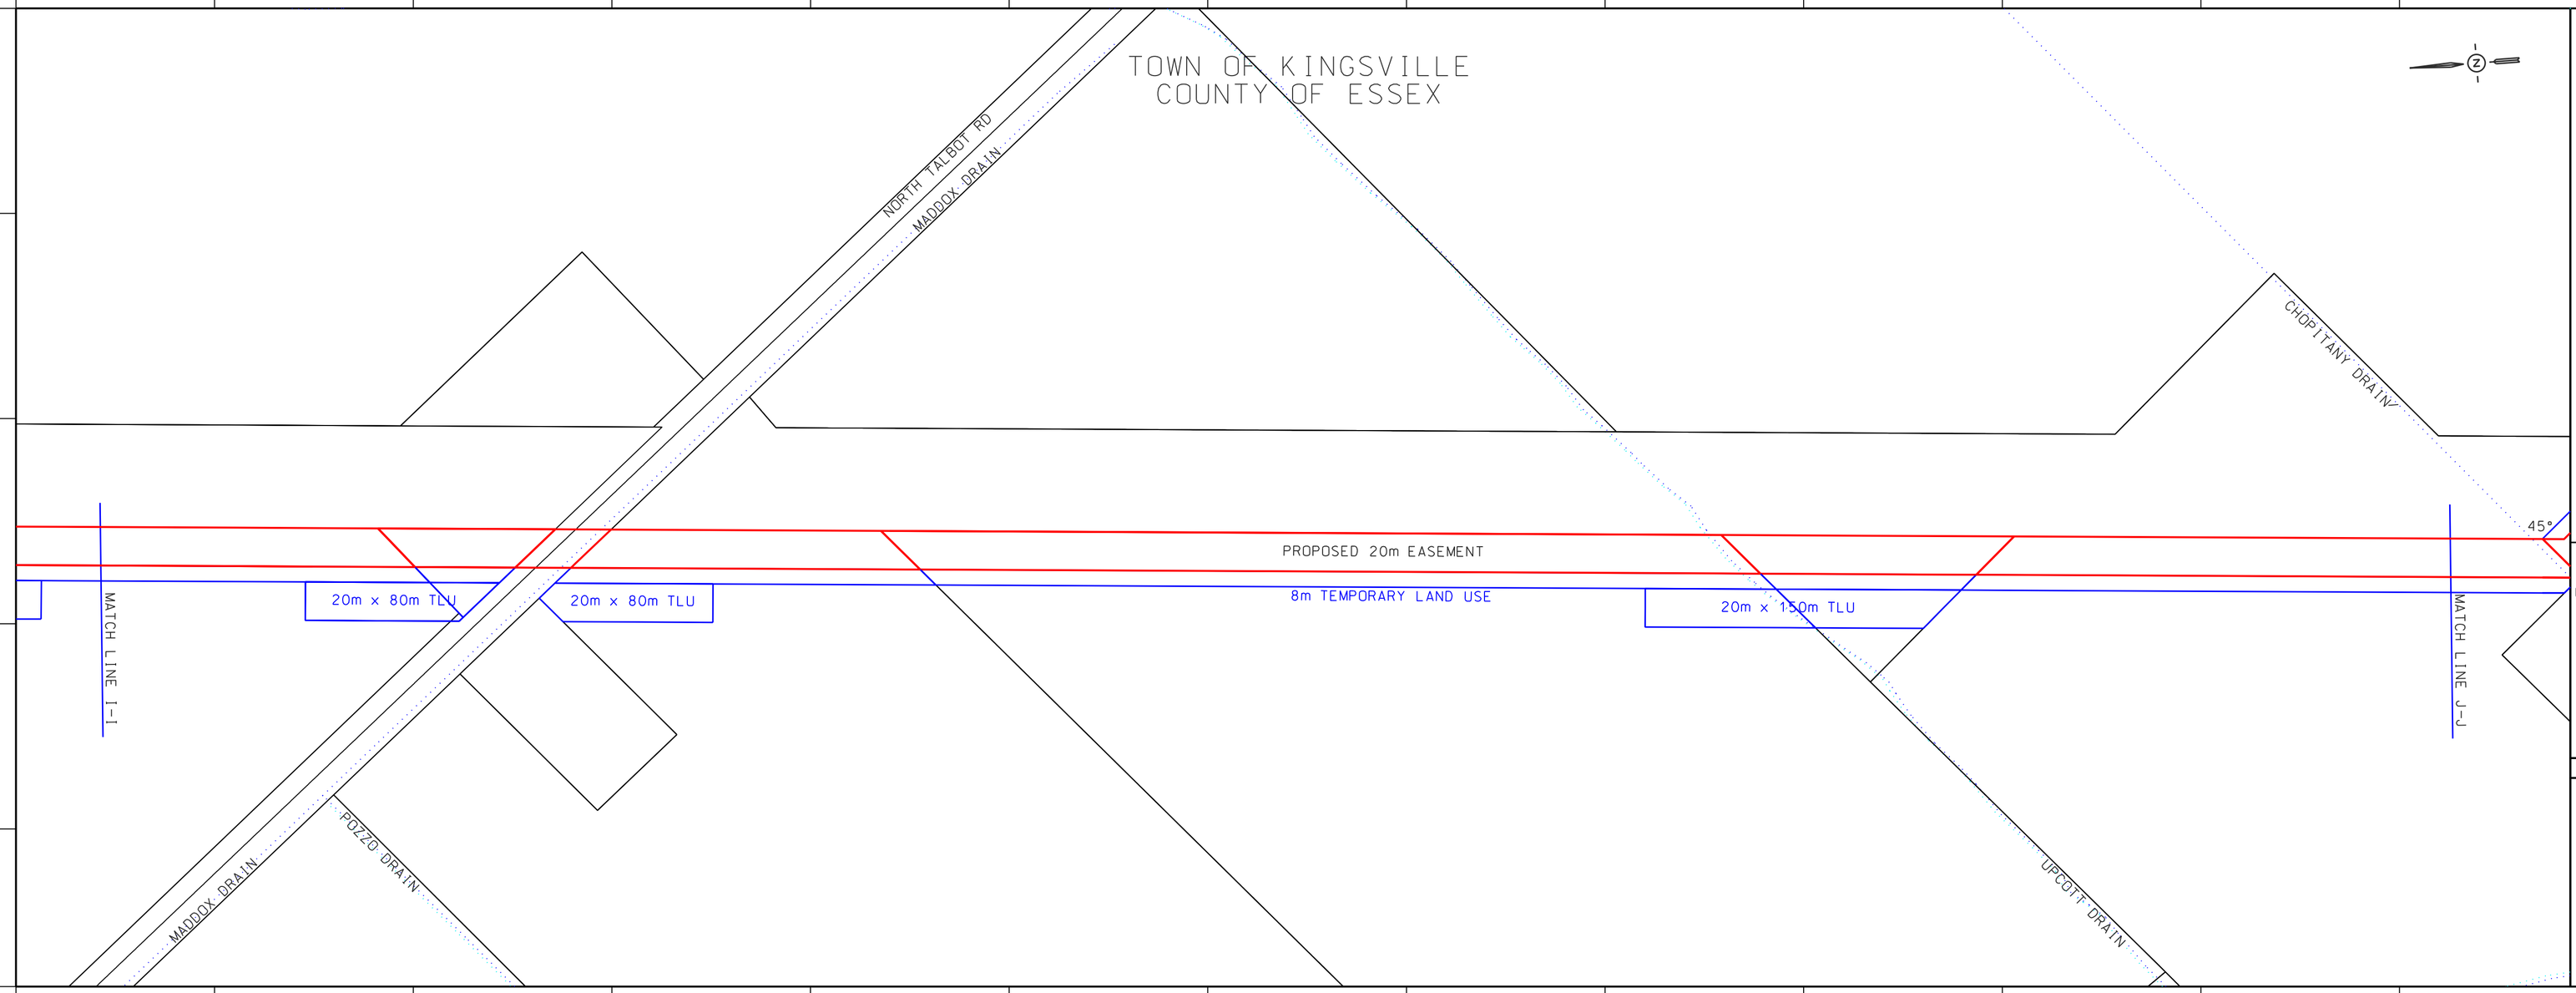

LEGEND

- PROPOSED PIPELINE -
- PROPOSED PIPELINE EASEMENT -
- TEMPORARY LAND USE -
- TEMPORARY LAND USE (NO IMAGERY) -
- NEW TEMPORARY LAND USE -
- EXISTING PIPELINE EASEMENT -
- MOZ AREAS -
- WATERCOURSE -

CONSTRUCTION NOTES:

1) CONTRACTOR RESPONSIBLE FOR ALL UTILITY LOCATES.
2) DEPTH OF MAIN TO BE 1.2m BELOW ℄ OF ROAD OR DITCH. WHICHEVER IS LOWER.
3) MINIMUM DEPTH OF COVER 1.2m. 1.5m FOR ALL ROAD AND CREEK CROSSINGS AND 3.25m FOR RAILWAY CROSSINGS.
4) MAINTAIN MIN. 500mm CLEARANCE BETWEEN PROPOSED MAIN AND OTHER UTILITIES AND UNDERGROUND STRUCTURES THAT ARE CROSSED.
5) ALL CULVERTS, END WALL TREATMENT AND TILE DRAINS REMOVED DURING CONSTRUCTION ARE TO BE RESTORED TO MATCH EXISTING CONDITIONS.
6) RESTORATION INCLUDES TOPSOIL AND SEEDING.
7) RESTORE DRIVEWAYS TO MATCH EXISTING.
8) ALL ASPHALT AREAS TO BE RESTORED TO MATCH EXISTING.
9) RESTORE ALL OPEN DRAINS TO MATCH ORIGINAL GRADE AND CONTOUR CONDITIONS.
10) ALL WORK MUST BE IN ACCORDANCE WITH THE UNION GAS CONSTRUCTION AND MAINTENANCE MANUAL SPECIFICATIONS.
11) ALL WELDS TO BE NON-DESTRUCTIVELY EXAMINED, AS PER C&M 3.6.8.

DESIGN PARAMETERS

DESIGN

- DESIGNED TO CSA Z662-15
- DESIGN FACTOR - 0.8
- LOCATION FACTOR - **
- DESIGN TEMPERATURE - MSC
- DESIGN PRESSURE - 6040 kPa

TEST PRESSURE

- MINIMUM - ****kPa
- MAXIMUM - ****kPa
- TEST DATE:_____

ENGINEER:

PRELIMINARY

12.5 0 25 50 75 METRES
25 0 25 50 75 100 125 250 FEET

No.	DATE	BY	APPD	REMARKS
A	2018-01-12	N.C.	D.T.L.	OEB FILING

REVISIONS

uniongas
An Enbridge Company

NPS 20 KINGSVILLE TRANSMISSION REINFORCEMENT PROJECT
2019 CONSTRUCTION - TOWN OF KINGSVILLE
GENERAL LOCATIONS - OEB FILING

DRAWN BY: MATT WADDICK	DATE: 2017-11-22	PLOT SPEC:	1:2000
CHECKED BY:	DATE:	CAD CODE:	PL1876-OEB-10.dgn
APPROVED BY:	DATE:	FILE REVISION DATE:	2018-01-12
SIZE: STRIP	SHEET: N/A	DRAWING No.:	PL1876-OEB-10

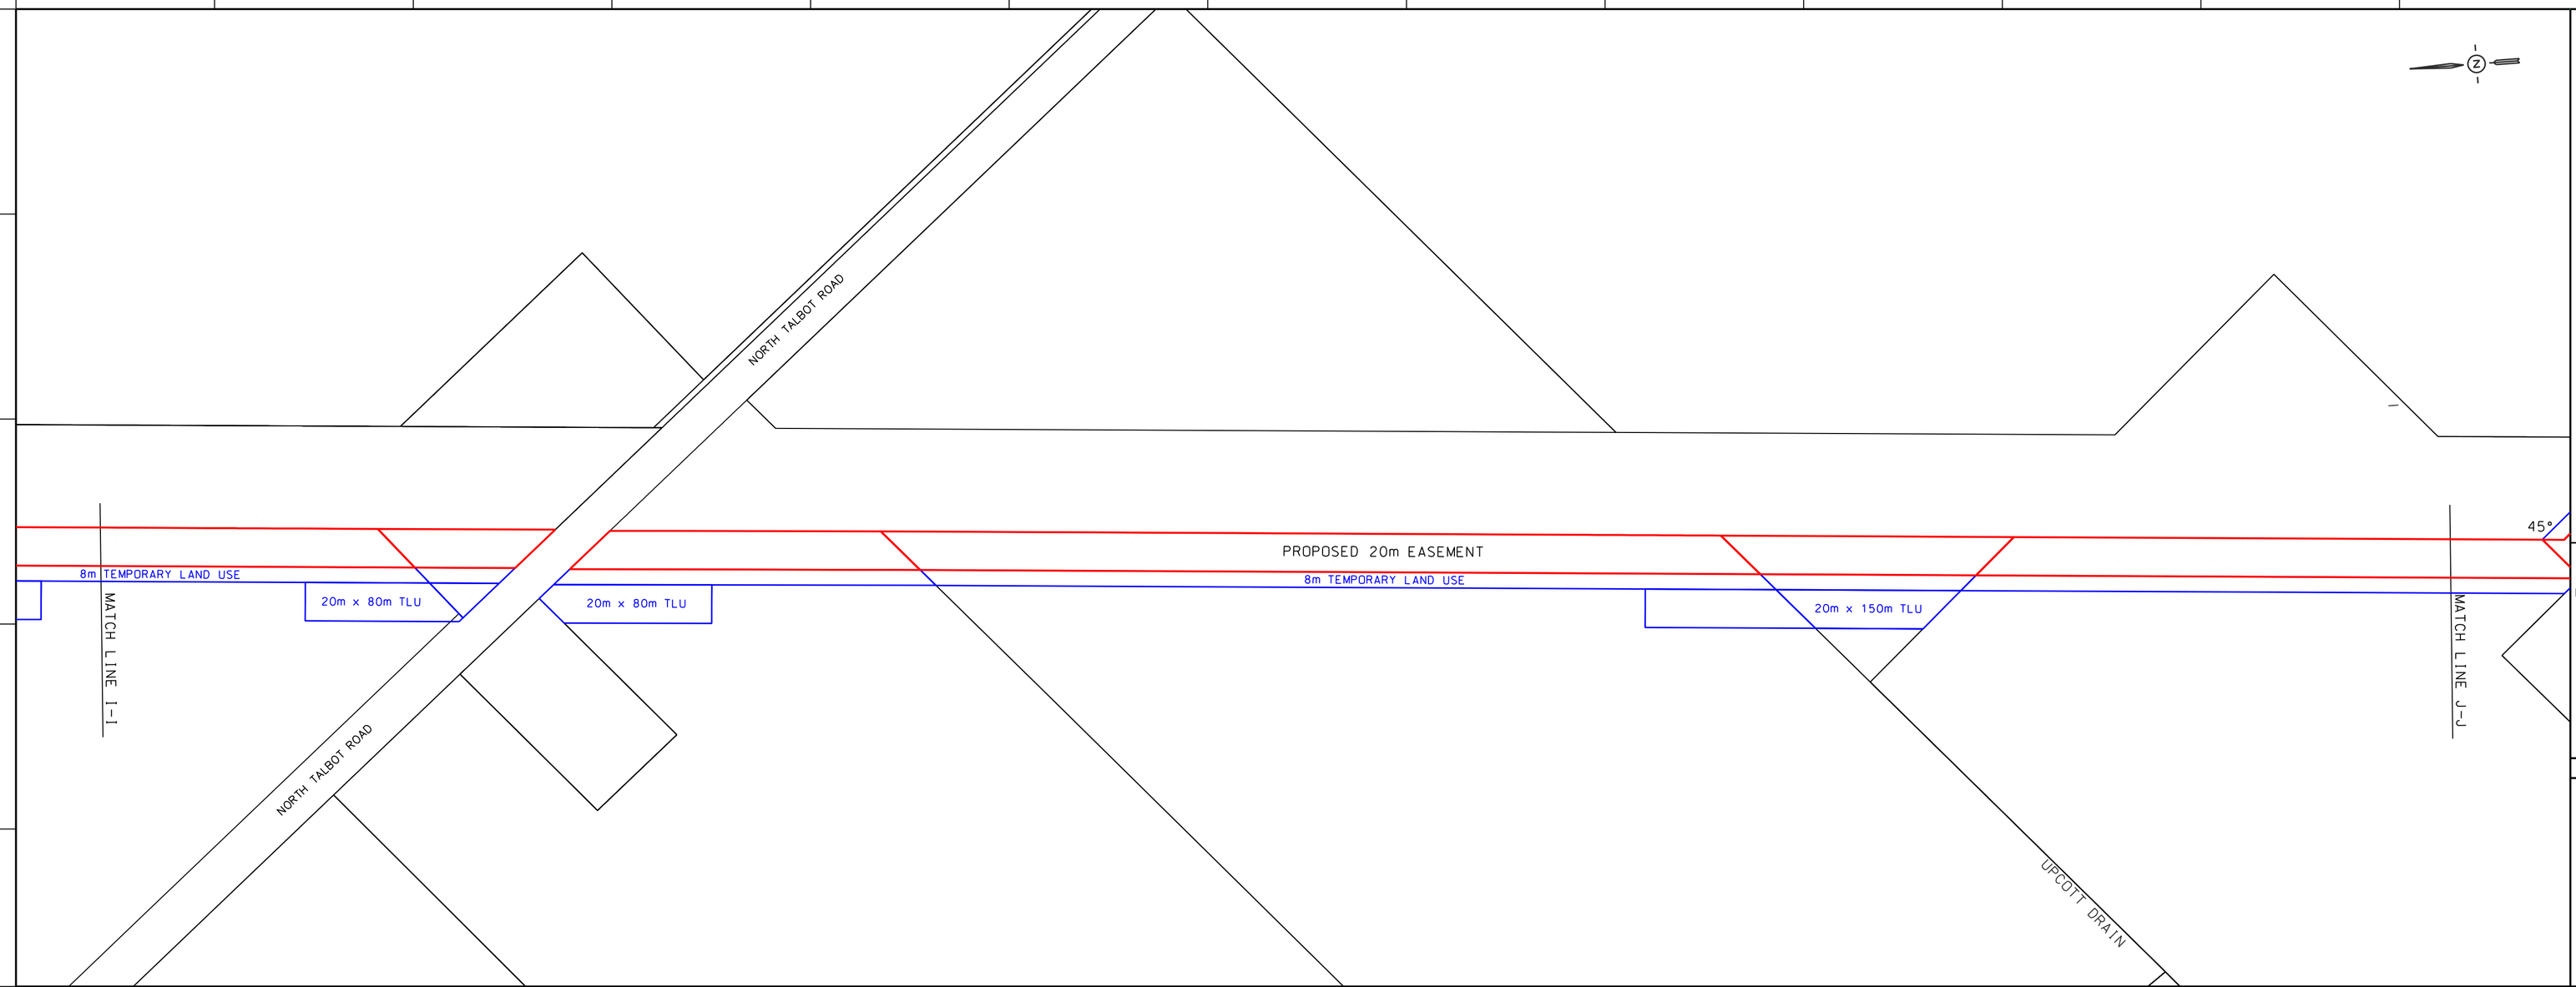

LEGEND

- PROPOSED PIPELINE -
- PROPOSED PIPELINE EASEMENT -
- TEMPORARY LAND USE -
- TEMPORARY LAND USE (NO IMAGERY) -
- NEW TEMPORARY LAND USE -
- EXISTING PIPELINE EASEMENT -
- MOZ AREAS -
- WATERCOURSE -

CONSTRUCTION NOTES:

1) CONTRACTOR RESPONSIBLE FOR ALL UTILITY LOCATES.
2) DEPTH OF MAIN TO BE 1.2m BELOW ℄ OF ROAD OR DITCH. WHICHEVER IS LOWER.
3) MINIMUM DEPTH OF COVER 1.2m. 1.5m FOR ALL ROAD AND CREEK CROSSINGS AND 3.25m FOR RAILWAY CROSSINGS.
4) MAINTAIN MIN. 500mm CLEARANCE BETWEEN PROPOSED MAIN AND OTHER UTILITIES AND UNDERGROUND STRUCTURES THAT ARE CROSSED.
5) ALL CULVERTS, END WALL TREATMENT AND TILE DRAINS REMOVED DURING CONSTRUCTION ARE TO BE RESTORED TO MATCH EXISTING CONDITIONS.
6) RESTORATION INCLUDES TOPSOIL AND SEEDING.
7) RESTORE DRIVEWAYS TO MATCH EXISTING.
8) ALL ASPHALT AREAS TO BE RESTORED TO MATCH EXISTING.
9) RESTORE ALL OPEN DRAINS TO MATCH ORIGINAL GRADE AND CONTOUR CONDITIONS.
10) ALL WORK MUST BE IN ACCORDANCE WITH THE UNION GAS CONSTRUCTION AND MAINTENANCE MANUAL SPECIFICATIONS.
11) ALL WELDS TO BE NON-DESTRUCTIVELY EXAMINED, AS PER C&M 3.6.8.

DESIGN PARAMETERS

DESIGN

- DESIGNED TO CSA Z662-15
- DESIGN FACTOR - 0.8
- LOCATION FACTOR - **
- DESIGN TEMPERATURE - MSC
- DESIGN PRESSURE - 6040 kPa

TEST PRESSURE

- MINIMUM - ****kPa
- MAXIMUM - ****kPa
- TEST DATE:_____

ENGINEER:

PRELIMINARY

12.5 0 25 50 75 METRES
25 0 25 50 75 100 125 250 FEET

No.	DATE	BY	APPD	REMARKS
B	2018-12-07	M.W.	D.T.L.	OEB FILING 2
A	2018-01-12	N.C.	D.T.L.	OEB FILING

REVISIONS

uniongas
An Enbridge Company

NPS 20 KINGSVILLE TRANSMISSION REINFORCEMENT PROJECT
2019 CONSTRUCTION - TOWN OF KINGSVILLE
GENERAL LOCATIONS - OEB FILING

DRAWN BY: MATT WADDICK	DATE: 2017-11-22	PLOT SPEC:	1:2000
CHECKED BY:	DATE:	CAD CODE:	PL1876-OEB-10.dgn
APPROVED BY:	DATE:	FILE REVISION DATE:	2018-12-07
SIZE: STRIP	SHEET: N/A	DRAWING No.:	PL1876-OEB-10

Filed: 2018-12-19
EB-2018-0013
Schedule 2 Change Request 1
Attachment 1 Redacted
Page 10 of 18

TOWN OF KINGSVILLE
COUNTY OF ESSEX

20m x 119m TLU
20m x 128m TLU
20m x 177m TLU
8m TEMPORARY LAND USE
PROPOSED 20m EASEMENT
20m x 600m TLU
90°
45°
CHOPITANY DRAIN
MATCH LINE J-J
UPCOTT DRAIN
8m TEMPORARY LAND USE
MATCH LINE K-K
20m x 600m TLU
10m x 80m
COUNTY ROAD 34 EAST
INMAN SIDE ROAD

LEGEND

- PROPOSED PIPELINE -
- PROPOSED PIPELINE EASEMENT -
- TEMPORARY LAND USE -
- TEMPORARY LAND USE (NO IMAGERY) -
- NEW TEMPORARY LAND USE -
- EXISTING PIPELINE EASEMENT -
- MOZ AREAS -
- WATERCOURSE -

CONSTRUCTION NOTES:

1) CONTRACTOR RESPONSIBLE FOR ALL UTILITY LOCATES.
2) DEPTH OF MAIN TO BE 1.2m BELOW ℄ OF ROAD OR DITCH. WHICHEVER IS LOWER.
3) MINIMUM DEPTH OF COVER 1.2m. 1.5m FOR ALL ROAD AND CREEK CROSSINGS AND 3.25m FOR RAILWAY CROSSINGS.
4) MAINTAIN MIN. 500mm CLEARANCE BETWEEN PROPOSED MAIN AND OTHER UTILITIES AND UNDERGROUND STRUCTURES THAT ARE CROSSED.
5) ALL CULVERTS, END WALL TREATMENT AND TILE DRAINS REMOVED DURING CONSTRUCTION ARE TO BE RESTORED TO MATCH EXISTING CONDITIONS.
6) RESTORATION INCLUDES TOPSOIL AND SEEDING.
7) RESTORE DRIVEWAYS TO MATCH EXISTING.
8) ALL ASPHALT AREAS TO BE RESTORED TO MATCH EXISTING.
9) RESTORE ALL OPEN DRAINS TO MATCH ORIGINAL GRADE AND CONTOUR CONDITIONS.
10) ALL WORK MUST BE IN ACCORDANCE WITH THE UNION GAS CONSTRUCTION AND MAINTENANCE MANUAL SPECIFICATIONS.
11) ALL WELDS TO BE NON-DESTRUCTIVELY EXAMINED, AS PER C&M 3.6.8.

DESIGN PARAMETERS

DESIGN

- DESIGNED TO CSA Z662-15
- DESIGN FACTOR - 0.8
- LOCATION FACTOR - **
- DESIGN TEMPERATURE - MSC
- DESIGN PRESSURE - 6040 kPa

TEST PRESSURE

- MINIMUM - ****kPa
- MAXIMUM - ****kPa
- TEST DATE:_____

ENGINEER:

PRELIMINARY

12.5 0 25 50 75 METRES
25 0 25 50 75 100 125 250 FEET

No.	DATE	BY	APP'D	REMARKS
A	2018-01-12	N.C.	D.T.J.	O.E.B. FILING

REVISIONS

uniongas
An Enbridge Company

NPS 20 KINGSVILLE TRANSMISSION REINFORCEMENT PROJECT
2019 CONSTRUCTION - TOWN OF KINGSVILLE
GENERAL LOCATIONS - OEB FILING

DRAWN BY: MATT WADDICK	DATE: 2017-11-22	PLOT SPEC:	1:2000@A1
CHECKED BY:	DATE:	CAD CODE:	PL1876-OEB-11.dgn
APPROVED BY:	DATE:	FILE REVISION DATE:	2018-01-12
SIZE: STRIP	SHEET: N/A	DRAWING No.:	PL1876-OEB-11

20m x 119m TLU
20m x 128m TLU
20m x 177m TLU
8m TEMPORARY LAND USE
PROPOSED 20m EASEMENT
20m x 600m TLU
90°
45°
MATCH LINE J-J
MATCH LINE K-K
20m x 600m TLU
COUNTY ROAD 34 EAST

LEGEND

- PROPOSED PIPELINE -
- PROPOSED PIPELINE EASEMENT -
- TEMPORARY LAND USE -
- TEMPORARY LAND USE (NO IMAGERY) -
- NEW TEMPORARY LAND USE -
- EXISTING PIPELINE EASEMENT -
- MOZ AREAS -
- WATERCOURSE -

CONSTRUCTION NOTES:

1) CONTRACTOR RESPONSIBLE FOR ALL UTILITY LOCATES.
2) DEPTH OF MAIN TO BE 1.2m BELOW ℄ OF ROAD OR DITCH. WHICHEVER IS LOWER.
3) MINIMUM DEPTH OF COVER 1.2m. 1.5m FOR ALL ROAD AND CREEK CROSSINGS AND 3.25m FOR RAILWAY CROSSINGS.
4) MAINTAIN MIN. 500mm CLEARANCE BETWEEN PROPOSED MAIN AND OTHER UTILITIES AND UNDERGROUND STRUCTURES THAT ARE CROSSED.
5) ALL CULVERTS, END WALL TREATMENT AND TILE DRAINS REMOVED DURING CONSTRUCTION ARE TO BE RESTORED TO MATCH EXISTING CONDITIONS.
6) RESTORATION INCLUDES TOPSOIL AND SEEDING.
7) RESTORE DRIVEWAYS TO MATCH EXISTING.
8) ALL ASPHALT AREAS TO BE RESTORED TO MATCH EXISTING.
9) RESTORE ALL OPEN DRAINS TO MATCH ORIGINAL GRADE AND CONTOUR CONDITIONS.
10) ALL WORK MUST BE IN ACCORDANCE WITH THE UNION GAS CONSTRUCTION AND MAINTENANCE MANUAL SPECIFICATIONS.
11) ALL WELDS TO BE NON-DESTRUCTIVELY EXAMINED, AS PER C&M 3.6.8.

DESIGN PARAMETERS

DESIGN

- DESIGNED TO CSA Z662-15
- DESIGN FACTOR - 0.8
- LOCATION FACTOR - **
- DESIGN TEMPERATURE - MSC
- DESIGN PRESSURE - 6040 kPa

TEST PRESSURE

- MINIMUM - ****kPa
- MAXIMUM - ****kPa
- TEST DATE:_____

ENGINEER:

PRELIMINARY

12.5 0 25 50 75 METRES
25 0 25 50 75 100 125 250 FEET

No.	DATE	BY	APP'D	REMARKS
B	2018-12-07	M.W.	D.T.J.	O.E.B. FILING 2
A	2018-01-12	N.C.	D.T.J.	O.E.B. FILING

REVISIONS

uniongas
An Enbridge Company

NPS 20 KINGSVILLE TRANSMISSION REINFORCEMENT PROJECT
2019 CONSTRUCTION - TOWN OF KINGSVILLE
GENERAL LOCATIONS - OEB FILING

DRAWN BY: MATT WADDICK	DATE: 2017-11-22	PLOT SPEC:	1:2000@A1
CHECKED BY:	DATE:	CAD CODE:	PL1876-OEB-11.dgn
APPROVED BY:	DATE:	FILE REVISION DATE:	2018-12-07
SIZE: STRIP	SHEET: N/A	DRAWING No.:	PL1876-OEB-11

Filed: 2018-12-19
EB-2018-0013
Schedule 1
Page 17 of 18
Change Request Redacted

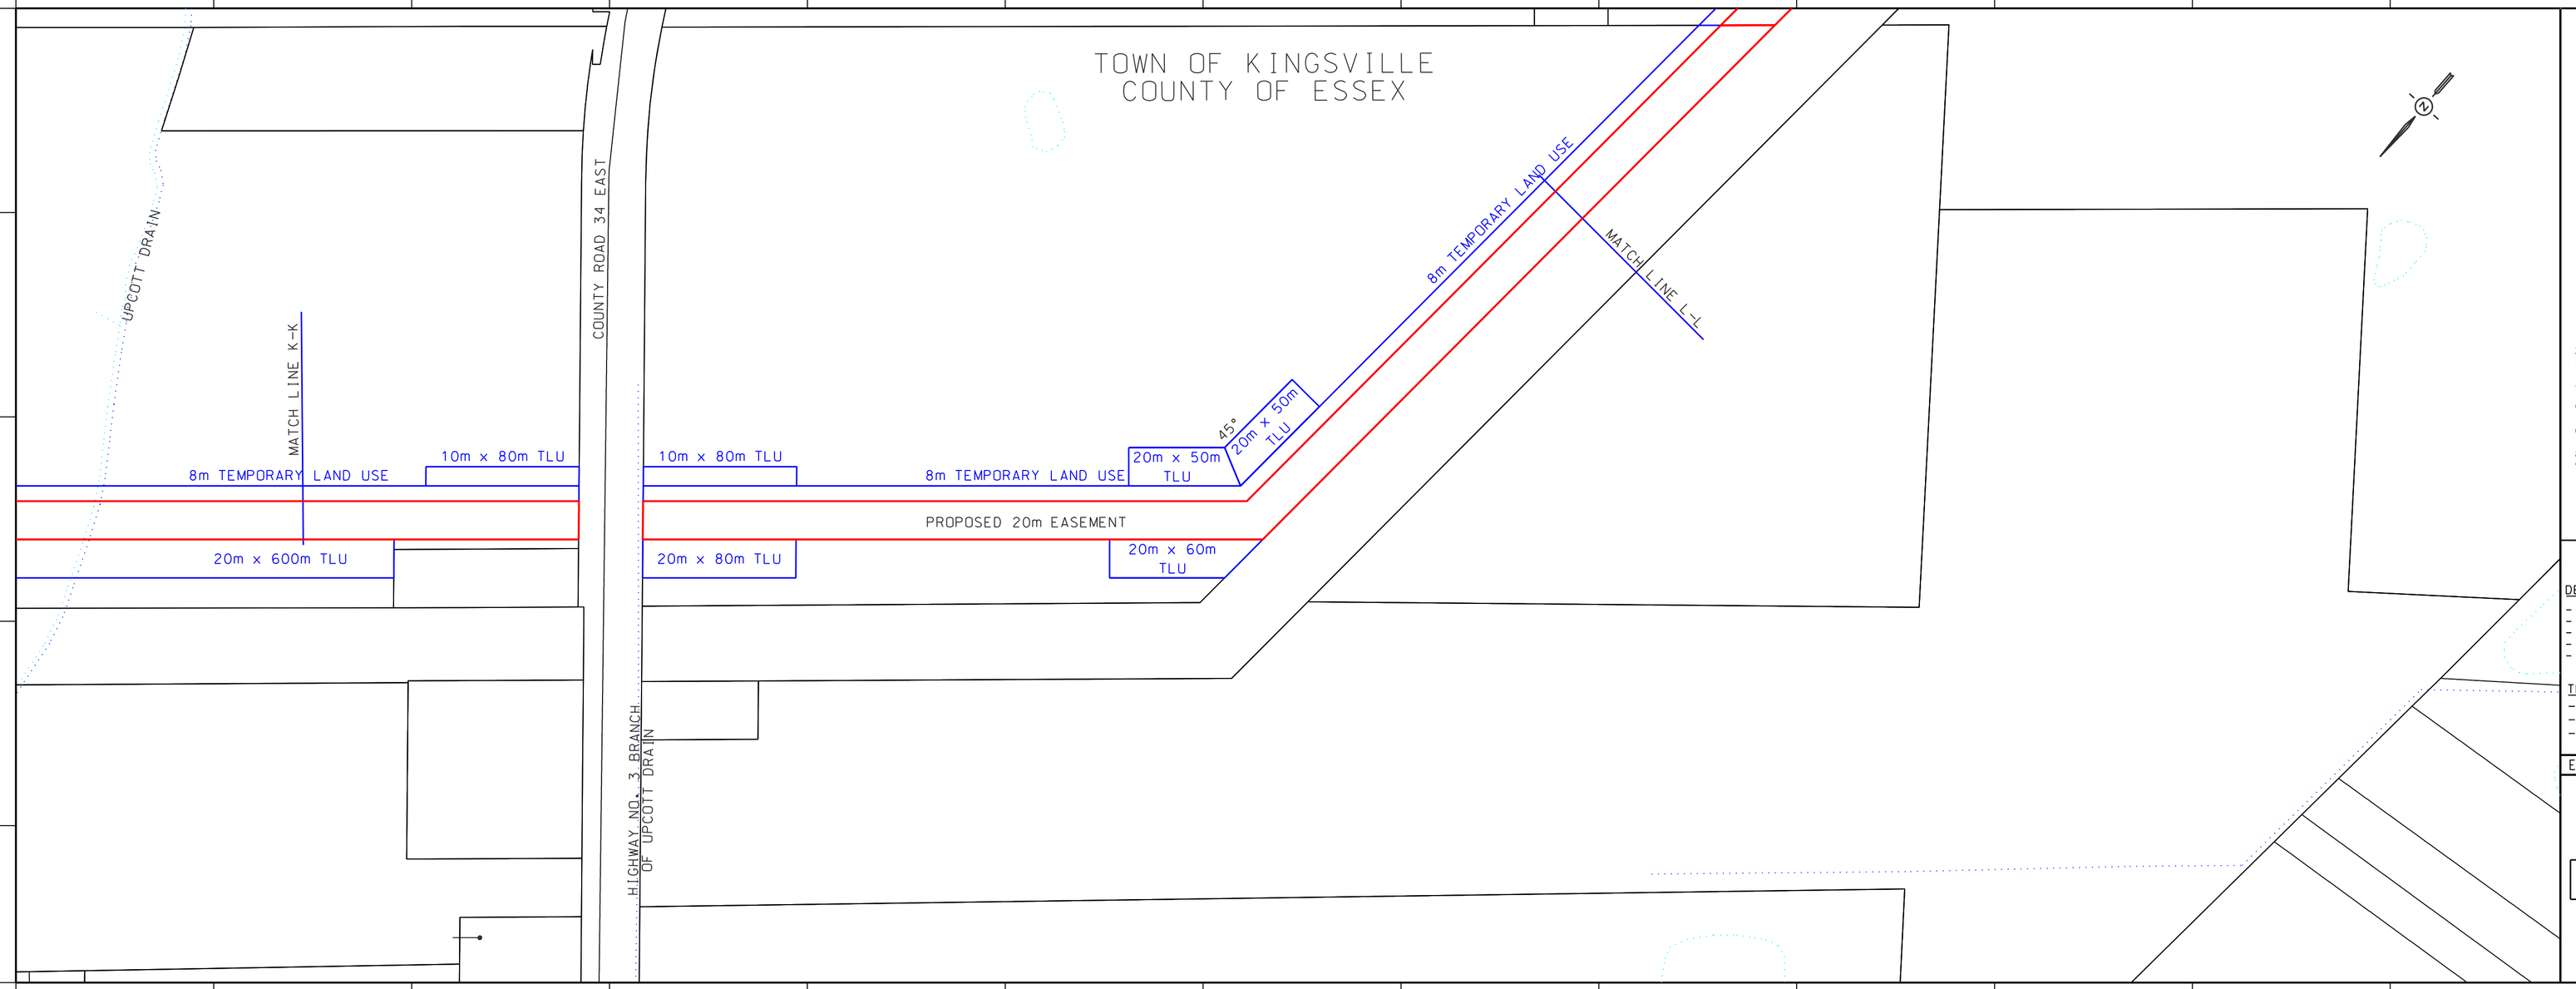

LEGEND

- PROPOSED PIPELINE -
- PROPOSED PIPELINE EASEMENT -
- TEMPORARY LAND USE -
- TEMPORARY LAND USE (NO IMAGERY) -
- NEW TEMPORARY LAND USE -
- EXISTING PIPELINE EASEMENT -
- MOZ AREAS -
- WATERCOURSE -

CONSTRUCTION NOTES:

1) CONTRACTOR RESPONSIBLE FOR ALL UTILITY LOCATES.
2) DEPTH OF MAIN TO BE 1.2m BELOW ℄ OF ROAD OR DITCH. WHICHEVER IS LOWER.
3) MINIMUM DEPTH OF COVER 1.2m. 1.5m FOR ALL ROAD AND CREEK CROSSINGS AND 3.25m FOR RAILWAY CROSSINGS.
4) MAINTAIN MIN. 500mm CLEARANCE BETWEEN PROPOSED MAIN AND OTHER UTILITIES AND UNDERGROUND STRUCTURES THAT ARE CROSSED.
5) ALL CULVERTS, END WALL TREATMENT AND TILE DRAINS REMOVED DURING CONSTRUCTION ARE TO BE RESTORED TO MATCH EXISTING CONDITIONS.
6) RESTORATION INCLUDES TOPSOIL AND SEEDING.
7) RESTORE DRIVEWAYS TO MATCH EXISTING.
8) ALL ASPHALT AREAS TO BE RESTORED TO MATCH EXISTING.
9) RESTORE ALL OPEN DRAINS TO MATCH ORIGINAL GRADE AND CONTOUR CONDITIONS.
10) ALL WORK MUST BE IN ACCORDANCE WITH THE UNION GAS CONSTRUCTION AND MAINTENANCE MANUAL SPECIFICATIONS.
11) ALL WELDS TO BE NON-DESTRUCTIVELY EXAMINED, AS PER C&M 3.6.8.

DESIGN PARAMETERS

DESIGN

- DESIGNED TO CSA Z662-15
- DESIGN FACTOR - 0.8
- LOCATION FACTOR - **
- DESIGN TEMPERATURE - MSC
- DESIGN PRESSURE - 6040 kPa

TEST PRESSURE

- MINIMUM - ****kPa
- MAXIMUM - ****kPa
- TEST DATE:_____

ENGINEER:

PRELIMINARY

12.5 0 25 50 75 METRES
25 0 25 50 75 100 125 250 FEET

No.	DATE	BY	APPD	REMARKS
A	2018-01-12	N.C.	D.T.L.	O.E.B. FILING

REVISIONS

uniongas
An Enbridge Company

NPS 20 KINGSVILLE TRANSMISSION REINFORCEMENT PROJECT
2019 CONSTRUCTION - TOWN OF KINGSVILLE
GENERAL LOCATIONS - OEB FILING

DRAWN BY: MATT WADDICK	DATE: 2017-11-22	PLOT SPEC:	1:2000
CHECKED BY:	DATE:	CAD CODE:	PL1876-OEB-12.dgn
APPROVED BY:	DATE:	FILE REVISION DATE:	2018-01-12
SIZE: STRIP	SHEET: N/A	DRAWING No.:	PL1876-OEB-12

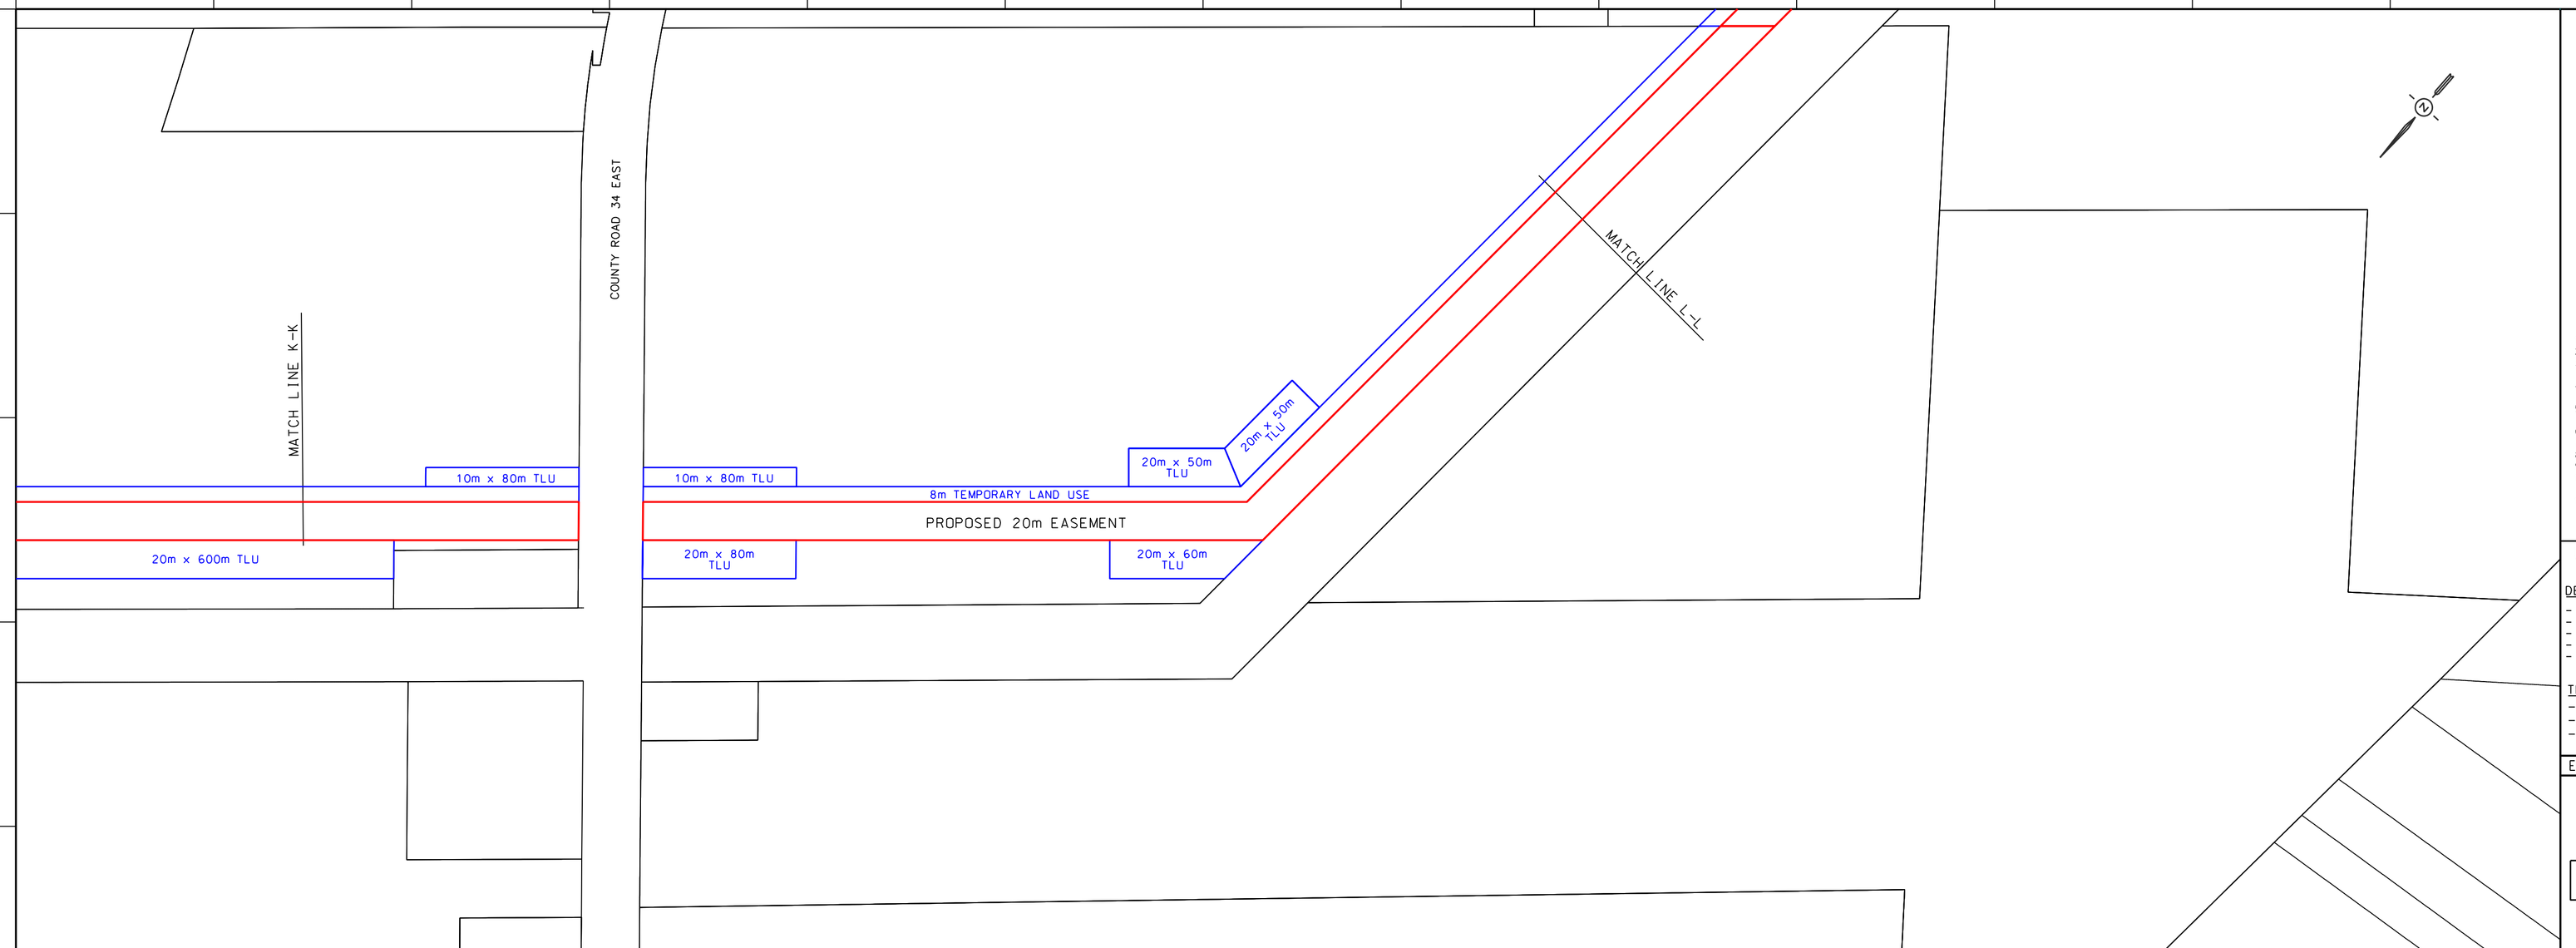

LEGEND

- PROPOSED PIPELINE -
- PROPOSED PIPELINE EASEMENT -
- TEMPORARY LAND USE -
- TEMPORARY LAND USE (NO IMAGERY) -
- NEW TEMPORARY LAND USE -
- EXISTING PIPELINE EASEMENT -
- MOZ AREAS -
- WATERCOURSE -

CONSTRUCTION NOTES:

1) CONTRACTOR RESPONSIBLE FOR ALL UTILITY LOCATES.
2) DEPTH OF MAIN TO BE 1.2m BELOW ℄ OF ROAD OR DITCH. WHICHEVER IS LOWER.
3) MINIMUM DEPTH OF COVER 1.2m. 1.5m FOR ALL ROAD AND CREEK CROSSINGS AND 3.25m FOR RAILWAY CROSSINGS.
4) MAINTAIN MIN. 500mm CLEARANCE BETWEEN PROPOSED MAIN AND OTHER UTILITIES AND UNDERGROUND STRUCTURES THAT ARE CROSSED.
5) ALL CULVERTS, END WALL TREATMENT AND TILE DRAINS REMOVED DURING CONSTRUCTION ARE TO BE RESTORED TO MATCH EXISTING CONDITIONS.
6) RESTORATION INCLUDES TOPSOIL AND SEEDING.
7) RESTORE DRIVEWAYS TO MATCH EXISTING.
8) ALL ASPHALT AREAS TO BE RESTORED TO MATCH EXISTING.
9) RESTORE ALL OPEN DRAINS TO MATCH ORIGINAL GRADE AND CONTOUR CONDITIONS.
10) ALL WORK MUST BE IN ACCORDANCE WITH THE UNION GAS CONSTRUCTION AND MAINTENANCE MANUAL SPECIFICATIONS.
11) ALL WELDS TO BE NON-DESTRUCTIVELY EXAMINED, AS PER C&M 3.6.8.

DESIGN PARAMETERS

DESIGN

- DESIGNED TO CSA Z662-15
- DESIGN FACTOR - 0.8
- LOCATION FACTOR - **
- DESIGN TEMPERATURE - MSC
- DESIGN PRESSURE - 6040 kPa

TEST PRESSURE

- MINIMUM - ****kPa
- MAXIMUM - ****kPa
- TEST DATE:_____

ENGINEER:

PRELIMINARY

12.5 0 25 50 75 METRES
25 0 25 50 75 100 125 250 FEET

No.	DATE	BY	APPD	REMARKS
B	2018-12-07	M.W.	D.T.L.	O.E.B. FILING 2
A	2018-01-12	N.C.	D.T.L.	O.E.B. FILING

REVISIONS

uniongas
An Enbridge Company

NPS 20 KINGSVILLE TRANSMISSION REINFORCEMENT PROJECT
2019 CONSTRUCTION - TOWN OF KINGSVILLE
GENERAL LOCATIONS - OEB FILING

DRAWN BY: MATT WADDICK	DATE: 2017-11-22	PLOT SPEC:	1:2000
CHECKED BY:	DATE:	CAD CODE:	PL1876-OEB-12.dgn
APPROVED BY:	DATE:	FILE REVISION DATE:	2018-12-07
SIZE: STRIP	SHEET: N/A	DRAWING No.:	PL1876-OEB-12

Filed: 2018-12-19
EB-2018-0013
Schedule 1
Change Request
Page 1 of 18

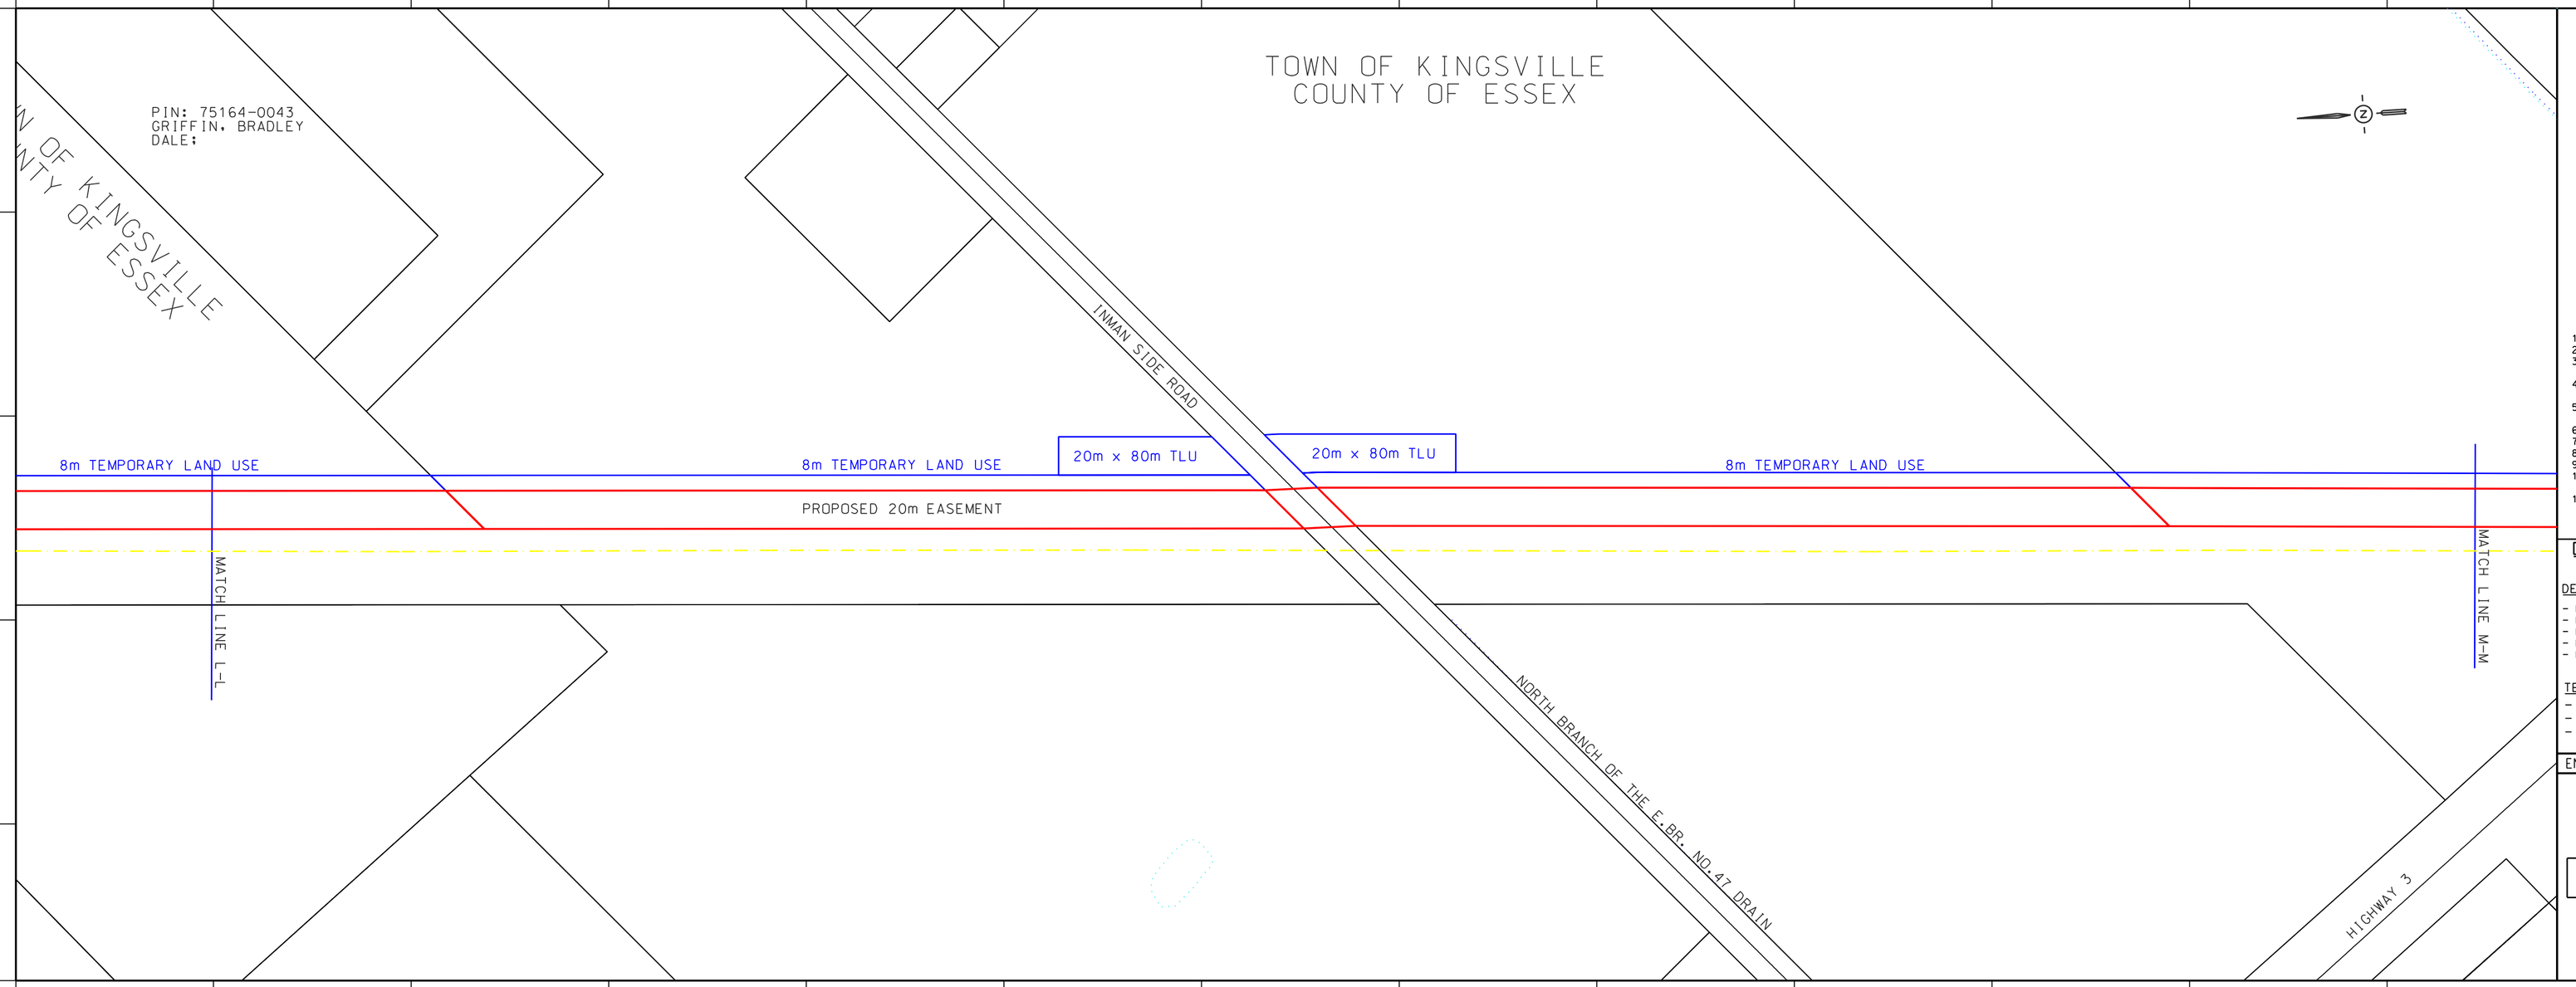

LEGEND

- PROPOSED PIPELINE -
- PROPOSED PIPELINE EASEMENT -
- TEMPORARY LAND USE -
- TEMPORARY LAND USE (NO IMAGERY) -
- NEW TEMPORARY LAND USE -
- EXISTING PIPELINE EASEMENT -
- MOZ AREAS -
- WATERCOURSE -

CONSTRUCTION NOTES:

1) CONTRACTOR RESPONSIBLE FOR ALL UTILITY LOCATES.
2) DEPTH OF MAIN TO BE 1.2m BELOW ℄ OF ROAD OR DITCH. WHICHEVER IS LOWER.
3) MINIMUM DEPTH OF COVER 1.2m. 1.5m FOR ALL ROAD AND CREEK CROSSINGS AND 3.25m FOR RAILWAY CROSSINGS.
4) MAINTAIN MIN. 500mm CLEARANCE BETWEEN PROPOSED MAIN AND OTHER UTILITIES AND UNDERGROUND STRUCTURES THAT ARE CROSSED.
5) ALL CULVERTS, END WALL TREATMENT AND TILE DRAINS REMOVED DURING CONSTRUCTION ARE TO BE RESTORED TO MATCH EXISTING CONDITIONS.
6) RESTORATION INCLUDES TOPSOIL AND SEEDING.
7) RESTORE DRIVEWAYS TO MATCH EXISTING.
8) ALL ASPHALT AREAS TO BE RESTORED TO MATCH EXISTING.
9) RESTORE ALL OPEN DRAINS TO MATCH ORIGINAL GRADE AND CONTOUR CONDITIONS.
10) ALL WORK MUST BE IN ACCORDANCE WITH THE UNION GAS CONSTRUCTION AND MAINTENANCE MANUAL SPECIFICATIONS.
11) ALL WELDS TO BE NON-DESTRUCTIVELY EXAMINED, AS PER C&M 3.6.8.

DESIGN PARAMETERS

DESIGN

- DESIGNED TO CSA Z662-15
- DESIGN FACTOR - 0.8
- LOCATION FACTOR - **
- DESIGN TEMPERATURE - MSC
- DESIGN PRESSURE - 6040 kPa

TEST PRESSURE

- MINIMUM - ****kPa
- MAXIMUM - ****kPa
- TEST DATE:_____

ENGINEER:

PRELIMINARY

12.5 0 25 50 75 METRES
25 0 25 50 75 100 125 250 FEET

No.	DATE	BY	APPD	REMARKS
A	2018-01-12	N.C.	D.T.L.	O.E.B. FILING

REVISIONS

uniongas
An Enbridge Company

NPS 20 KINGSVILLE TRANSMISSION REINFORCEMENT PROJECT
2019 CONSTRUCTION - TOWN OF KINGSVILLE
GENERAL LOCATIONS - OEB FILING

DRAWN BY: MATT WADDICK	DATE: 2017-11-22	PLOT SPEC:	1:2000
CHECKED BY:	DATE:	CAD CODE:	PL1876-OEB-13.dgn
APPROVED BY:	DATE:	FILE REVISION DATE:	2018-01-12
SIZE: STRIP	SHEET: N/A	DRAWING No.:	PL1876-OEB-13

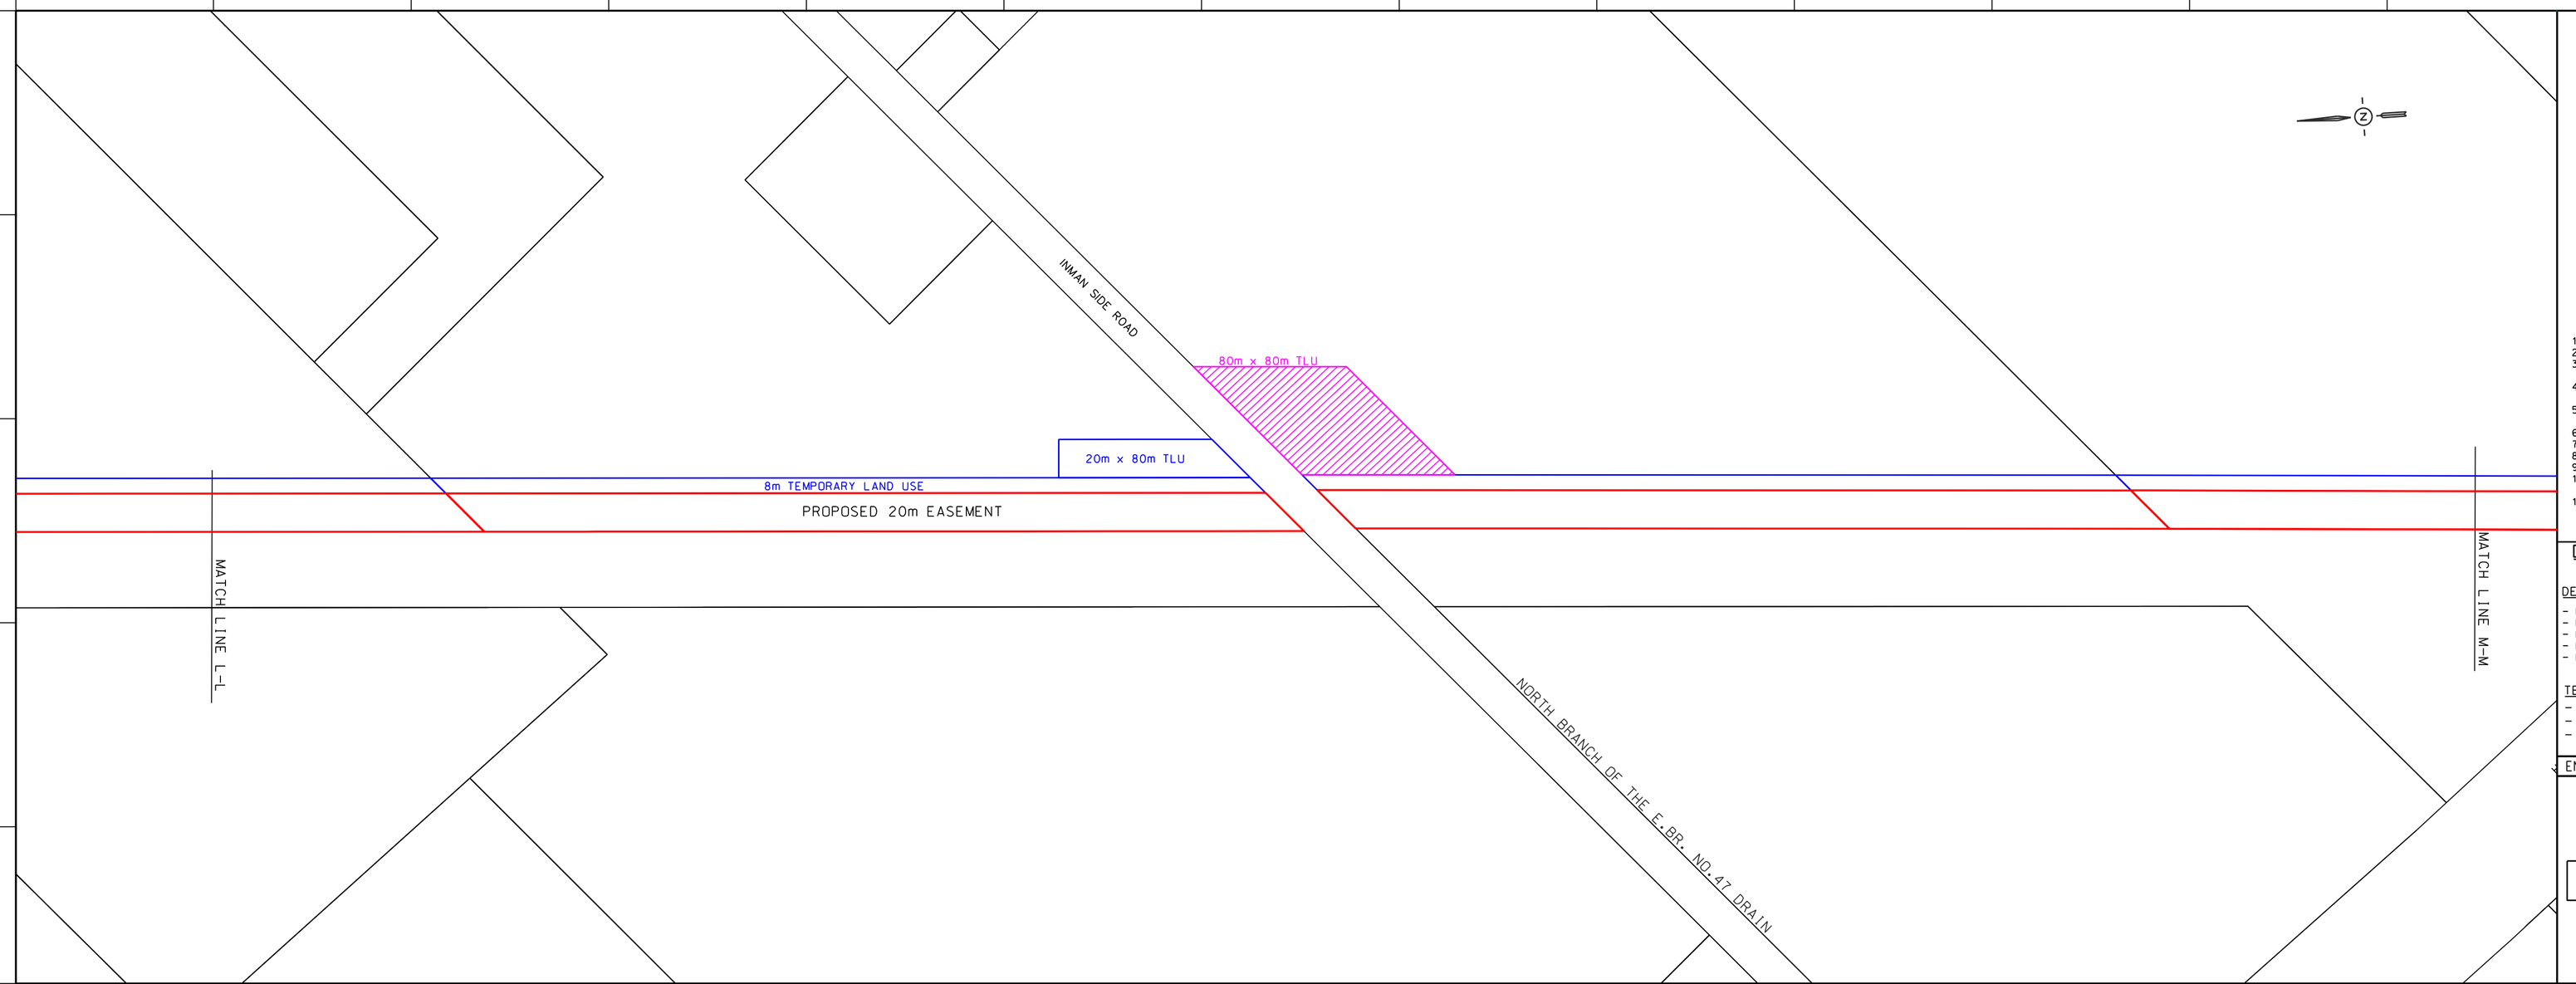

LEGEND

- PROPOSED PIPELINE -
- PROPOSED PIPELINE EASEMENT -
- TEMPORARY LAND USE -
- TEMPORARY LAND USE (NO IMAGERY) -
- NEW TEMPORARY LAND USE -
- EXISTING PIPELINE EASEMENT -
- MOZ AREAS -
- WATERCOURSE -

CONSTRUCTION NOTES:

1) CONTRACTOR RESPONSIBLE FOR ALL UTILITY LOCATES.
2) DEPTH OF MAIN TO BE 1.2m BELOW ℄ OF ROAD OR DITCH. WHICHEVER IS LOWER.
3) MINIMUM DEPTH OF COVER 1.2m. 1.5m FOR ALL ROAD AND CREEK CROSSINGS AND 3.25m FOR RAILWAY CROSSINGS.
4) MAINTAIN MIN. 500mm CLEARANCE BETWEEN PROPOSED MAIN AND OTHER UTILITIES AND UNDERGROUND STRUCTURES THAT ARE CROSSED.
5) ALL CULVERTS, END WALL TREATMENT AND TILE DRAINS REMOVED DURING CONSTRUCTION ARE TO BE RESTORED TO MATCH EXISTING CONDITIONS.
6) RESTORATION INCLUDES TOPSOIL AND SEEDING.
7) RESTORE DRIVEWAYS TO MATCH EXISTING.
8) ALL ASPHALT AREAS TO BE RESTORED TO MATCH EXISTING.
9) RESTORE ALL OPEN DRAINS TO MATCH ORIGINAL GRADE AND CONTOUR CONDITIONS.
10) ALL WORK MUST BE IN ACCORDANCE WITH THE UNION GAS CONSTRUCTION AND MAINTENANCE MANUAL SPECIFICATIONS.
11) ALL WELDS TO BE NON-DESTRUCTIVELY EXAMINED, AS PER C&M 3.6.8.

DESIGN PARAMETERS

DESIGN

- DESIGNED TO CSA Z662-15
- DESIGN FACTOR - 0.8
- LOCATION FACTOR - **
- DESIGN TEMPERATURE - MSC
- DESIGN PRESSURE - 6040 kPa

TEST PRESSURE

- MINIMUM - ****kPa
- MAXIMUM - ****kPa
- TEST DATE:_____

ENGINEER:

PRELIMINARY

12.5 0 25 50 75 METRES
25 0 25 50 75 100 125 250 FEET

No.	DATE	BY	APPD	REMARKS
B	2018-12-07	M.W.	D.T.L.	O.E.B. FILING 2
A	2018-01-12	N.C.	D.T.L.	O.E.B. FILING

REVISIONS

uniongas
An Enbridge Company

NPS 20 KINGSVILLE TRANSMISSION REINFORCEMENT PROJECT
2019 CONSTRUCTION - TOWN OF KINGSVILLE
GENERAL LOCATIONS - OEB FILING

DRAWN BY: MATT WADDICK	DATE: 2017-11-22	PLOT SPEC:	1:2000
CHECKED BY:	DATE:	CAD CODE:	PL1876-OEB-13.dgn
APPROVED BY:	DATE:	FILE REVISION DATE:	2018-12-07
SIZE: STRIP	SHEET: N/A	DRAWING No.:	PL1876-OEB-13

Filed: 2018-12-19
EB-2018-0013
Schedule 1
Change Request 1
Page 18 of 18

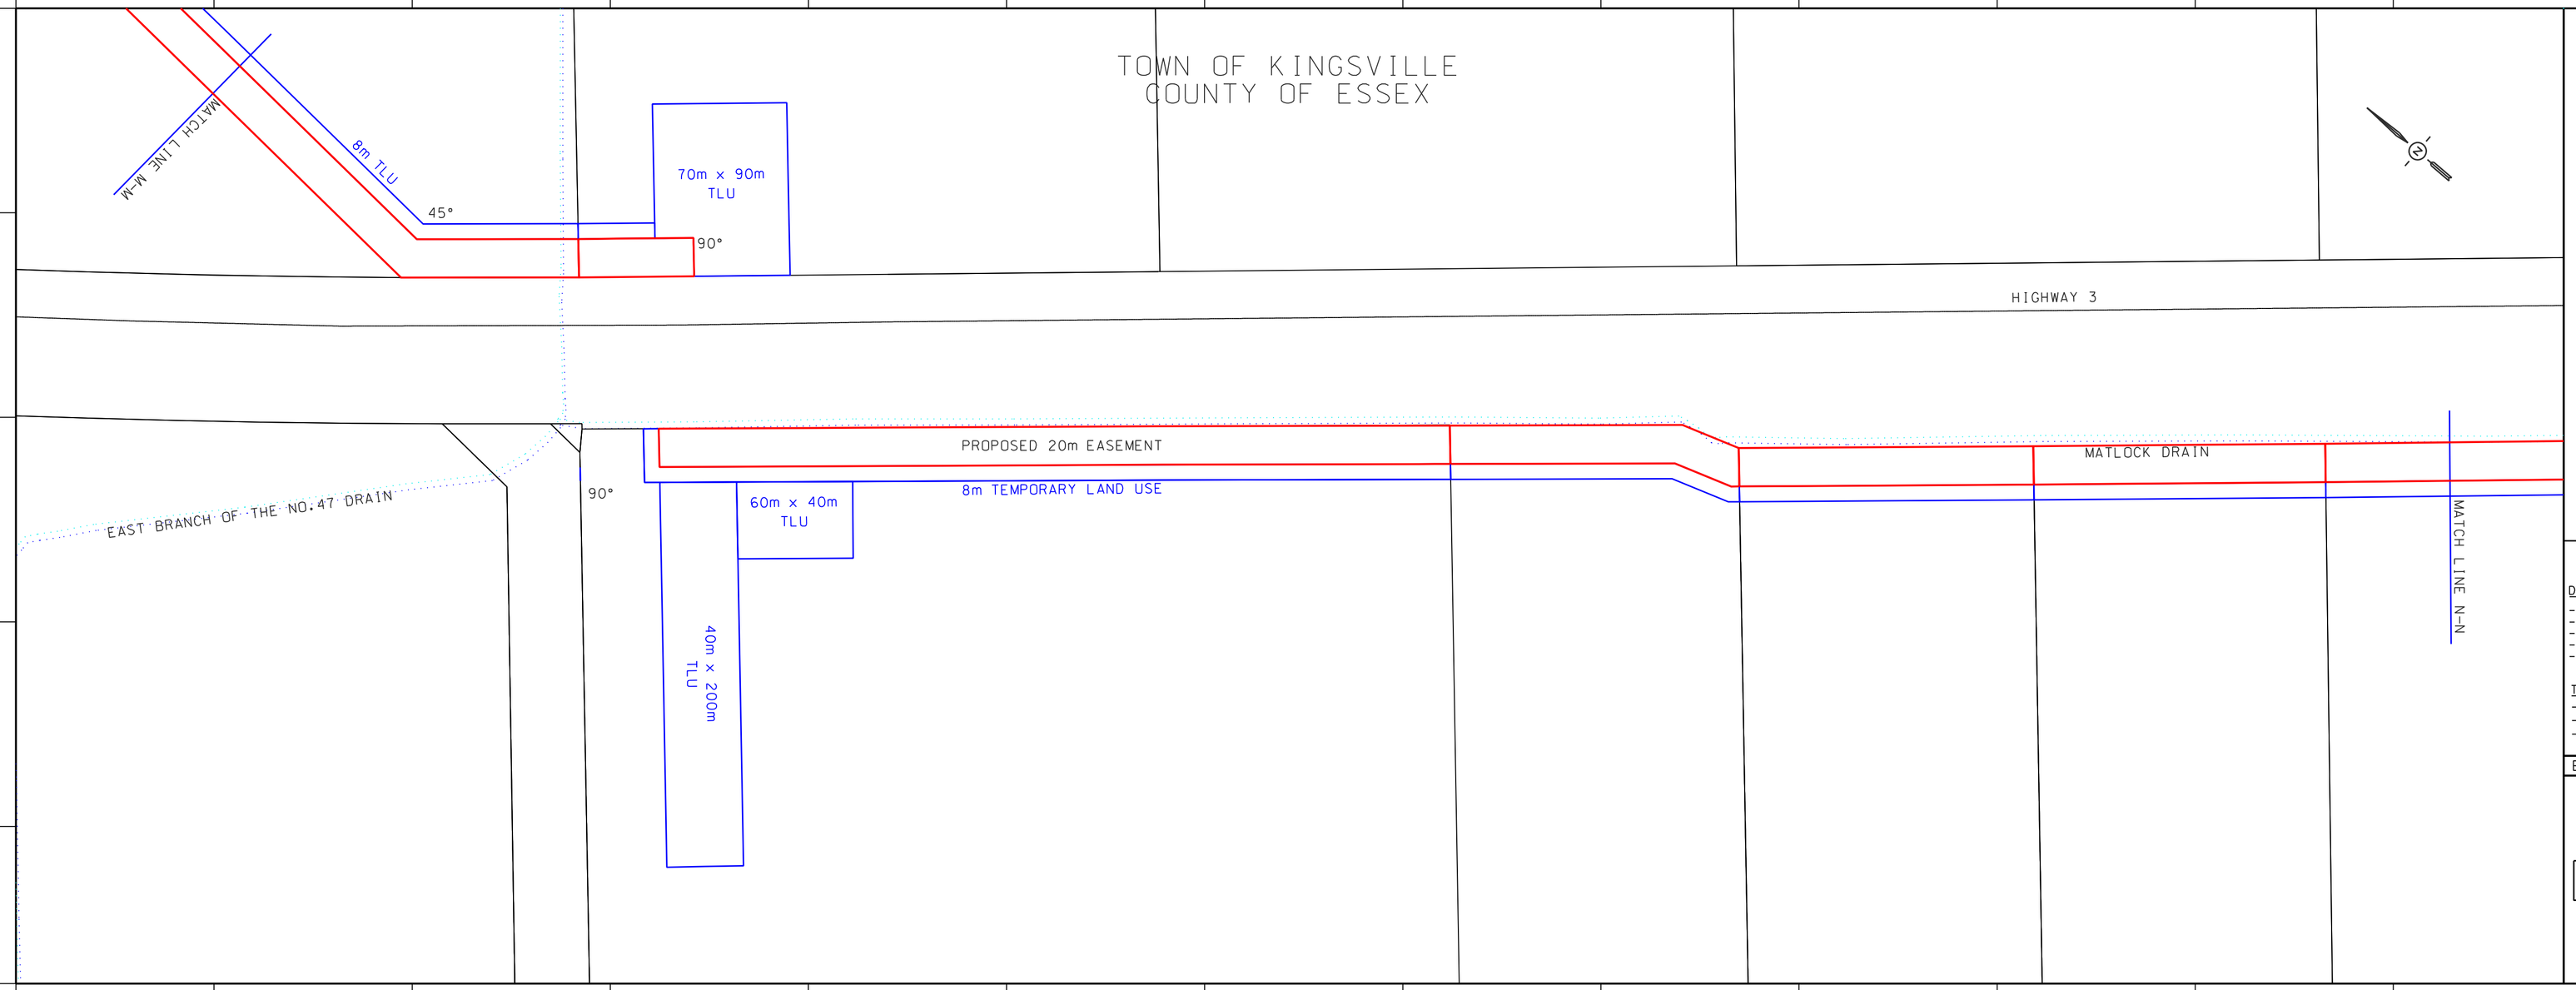

LEGEND

- PROPOSED PIPELINE
- PROPOSED PIPELINE EASEMENT
- TEMPORARY LAND USE
- TEMPORARY LAND USE (NO IMAGERY)
- NEW TEMPORARY LAND USE
- EXISTING PIPELINE EASEMENT
- MOZ AREAS
- WATERCOURSE

CONSTRUCTION NOTES:

1) CONTRACTOR RESPONSIBLE FOR ALL UTILITY LOCATES.
2) DEPTH OF MAIN TO BE 1.2m BELOW ℄ OF ROAD OR DITCH. WHICHEVER IS LOWER.
3) MINIMUM DEPTH OF COVER 1.2m. 1.5m FOR ALL ROAD AND CREEK CROSSINGS AND 3.25m FOR RAILWAY CROSSINGS.
4) MAINTAIN MIN. 500mm CLEARANCE BETWEEN PROPOSED MAIN AND OTHER UTILITIES AND UNDERGROUND STRUCTURES THAT ARE CROSSED.
5) ALL CULVERTS, END WALL TREATMENT AND TILE DRAINS REMOVED DURING CONSTRUCTION ARE TO BE RESTORED TO MATCH EXISTING CONDITIONS.
6) RESTORATION INCLUDES TOPSOIL AND SEEDING.
7) RESTORE DRIVEWAYS TO MATCH EXISTING.
8) ALL ASPHALT AREAS TO BE RESTORED TO MATCH EXISTING.
9) RESTORE ALL OPEN DRAINS TO MATCH ORIGINAL GRADE AND CONTOUR CONDITIONS.
10) ALL WORK MUST BE IN ACCORDANCE WITH THE UNION GAS CONSTRUCTION AND MAINTENANCE MANUAL SPECIFICATIONS.
11) ALL WELDS TO BE NON-DESTRUCTIVELY EXAMINED, AS PER C&M 3.6.8.

DESIGN PARAMETERS

DESIGN

- DESIGNED TO CSA Z662-15
- DESIGN FACTOR - 0.8
- LOCATION FACTOR - **
- DESIGN TEMPERATURE - MSC
- DESIGN PRESSURE - 6040 kPa

TEST PRESSURE

- MINIMUM - ****kPa
- MAXIMUM - ****kPa
- TEST DATE:_____

ENGINEER:

PRELIMINARY

12.5 0 25 50 75 METRES
25 0 25 50 75 100 125 250 FEET

No.	DATE	BY	APPD	REMARKS
A	2018-01-12	N.C.	D.T.L.	O.E.B. FILING

REVISIONS

uniongas
An Enbridge Company

NPS 20 KINGSVILLE TRANSMISSION REINFORCEMENT PROJECT
2019 CONSTRUCTION - TOWN OF KINGSVILLE
GENERAL LOCATIONS - OEB FILING

DRAWN BY: MATT WADDICK	DATE: 2017-11-22	PLOT SPEC:	1:2000
CHECKED BY:	DATE:	CAD CODE:	PL1876-OEB-14.dgn
APPROVED BY:	DATE:	FILE REVISION DATE:	2018-01-12
SIZE: STRIP	SHEET: N/A	DRAWING No.:	PL1876-OEB-14

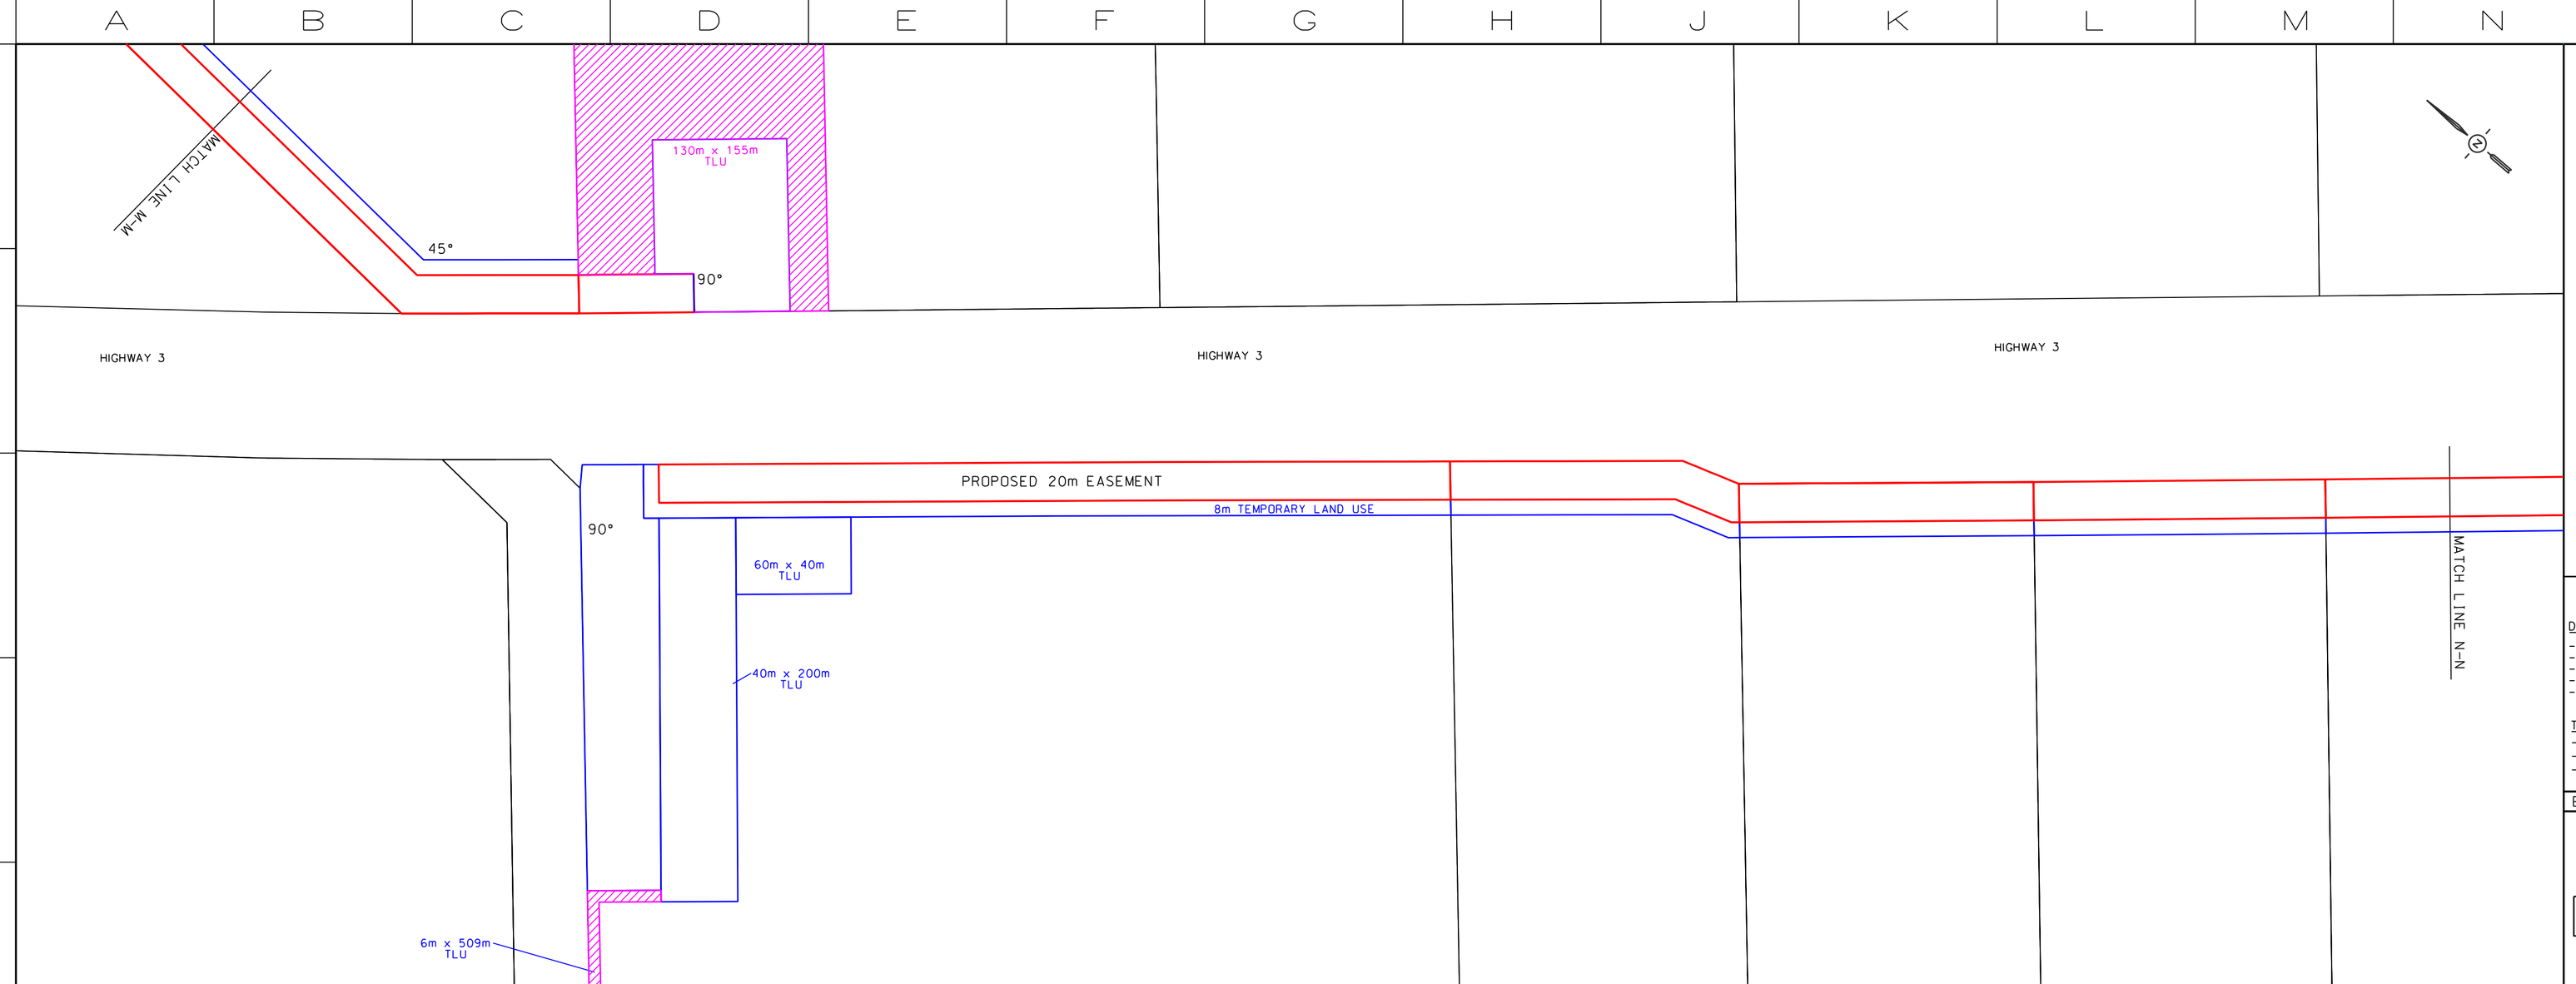

LEGEND

- PROPOSED PIPELINE
- PROPOSED PIPELINE EASEMENT
- TEMPORARY LAND USE
- TEMPORARY LAND USE (NO IMAGERY)
- NEW TEMPORARY LAND USE
- EXISTING PIPELINE EASEMENT
- MOZ AREAS
- WATERCOURSE

CONSTRUCTION NOTES:

1) CONTRACTOR RESPONSIBLE FOR ALL UTILITY LOCATES.
2) DEPTH OF MAIN TO BE 1.2m BELOW ℄ OF ROAD OR DITCH. WHICHEVER IS LOWER.
3) MINIMUM DEPTH OF COVER 1.2m. 1.5m FOR ALL ROAD AND CREEK CROSSINGS AND 3.25m FOR RAILWAY CROSSINGS.
4) MAINTAIN MIN. 500mm CLEARANCE BETWEEN PROPOSED MAIN AND OTHER UTILITIES AND UNDERGROUND STRUCTURES THAT ARE CROSSED.
5) ALL CULVERTS, END WALL TREATMENT AND TILE DRAINS REMOVED DURING CONSTRUCTION ARE TO BE RESTORED TO MATCH EXISTING CONDITIONS.
6) RESTORATION INCLUDES TOPSOIL AND SEEDING.
7) RESTORE DRIVEWAYS TO MATCH EXISTING.
8) ALL ASPHALT AREAS TO BE RESTORED TO MATCH EXISTING.
9) RESTORE ALL OPEN DRAINS TO MATCH ORIGINAL GRADE AND CONTOUR CONDITIONS.
10) ALL WORK MUST BE IN ACCORDANCE WITH THE UNION GAS CONSTRUCTION AND MAINTENANCE MANUAL SPECIFICATIONS.
11) ALL WELDS TO BE NON-DESTRUCTIVELY EXAMINED, AS PER C&M 3.6.8.

DESIGN PARAMETERS

DESIGN

- DESIGNED TO CSA Z662-15
- DESIGN FACTOR - 0.8
- LOCATION FACTOR - **
- DESIGN TEMPERATURE - MSC
- DESIGN PRESSURE - 6040 kPa

TEST PRESSURE

- MINIMUM - ****kPa
- MAXIMUM - ****kPa
- TEST DATE:_____

ENGINEER:

PRELIMINARY

12.5 0 25 50 75 METRES
25 0 25 50 75 100 125 250 FEET

No.	DATE	BY	APPD	REMARKS
B	2018-12-07	M.W.	D.T.L.	O.E.B. FILING 2
A	2018-01-12	N.C.	D.T.L.	O.E.B. FILING

REVISIONS

uniongas
An Enbridge Company

NPS 20 KINGSVILLE TRANSMISSION REINFORCEMENT PROJECT
2019 CONSTRUCTION - TOWN OF KINGSVILLE
GENERAL LOCATIONS - OEB FILING

DRAWN BY: MATT WADDICK	DATE: 2017-11-22	PLOT SPEC:	1:2000
CHECKED BY:	DATE:	CAD CODE:	PL1876-OEB-14.dgn
APPROVED BY:	DATE:	FILE REVISION DATE:	2018-12-07
SIZE: STRIP	SHEET: N/A	DRAWING No.:	PL1876-OEB-14

Filed: 2018-12-19
EB-2018-0013
Schedule 1
Page 14 of 18
Change Request 1
Redacted

TOWN OF KINGSVILLE
COUNTY OF ESSEX

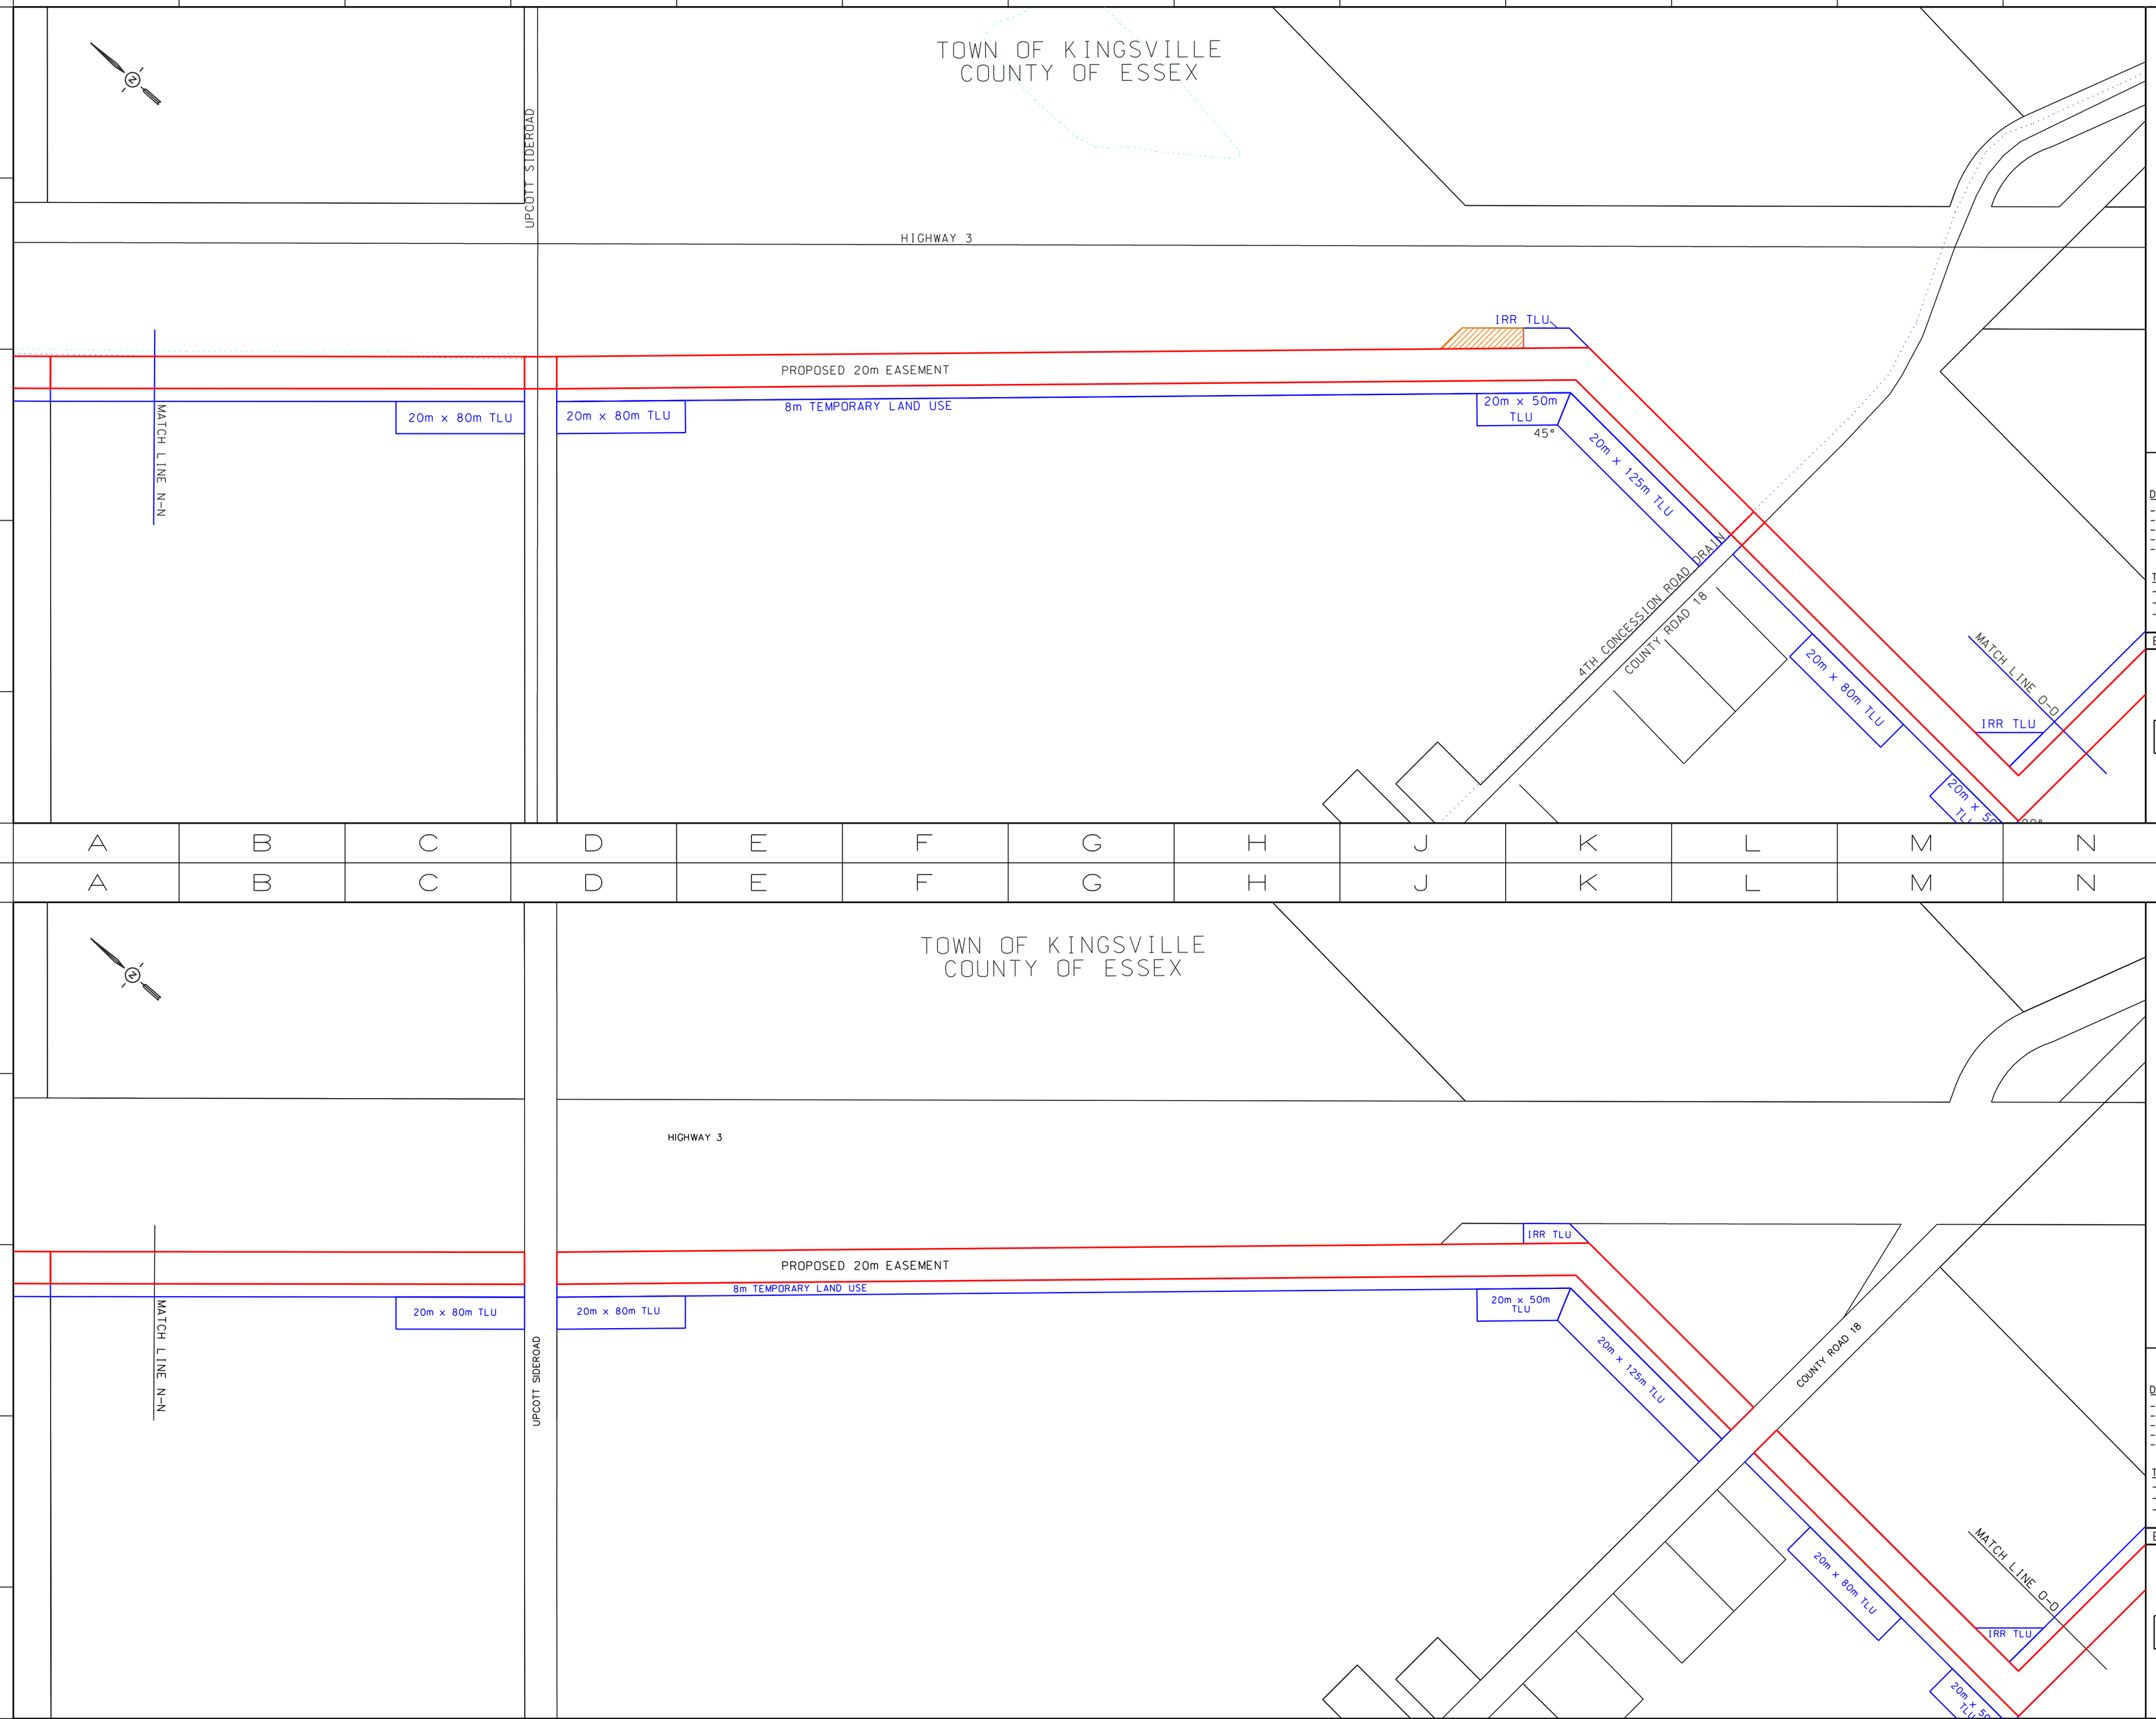

LEGEND

- PROPOSED PIPELINE
- PROPOSED PIPELINE EASEMENT
- TEMPORARY LAND USE
- TEMPORARY LAND USE (NO IMAGERY)
- NEW TEMPORARY LAND USE
- EXISTING PIPELINE EASEMENT
- MOZ AREAS
- WATERCOURSE

CONSTRUCTION NOTES:

1) CONTRACTOR RESPONSIBLE FOR ALL UTILITY LOCATES.
2) DEPTH OF MAIN TO BE 1.2m BELOW ℄ OF ROAD OR DITCH. WHICHEVER IS LOWER.
3) MINIMUM DEPTH OF COVER 1.2m. 1.5m FOR ALL ROAD AND CREEK CROSSINGS AND 3.25m FOR RAILWAY CROSSINGS.
4) MAINTAIN MIN. 500mm CLEARANCE BETWEEN PROPOSED MAIN AND OTHER UTILITIES AND UNDERGROUND STRUCTURES THAT ARE CROSSED.
5) ALL CULVERTS, END WALL TREATMENT AND TILE DRAINS REMOVED DURING CONSTRUCTION ARE TO BE RESTORED TO MATCH EXISTING CONDITIONS.
6) RESTORATION INCLUDES TOPSOIL AND SEEDING.
7) RESTORE DRIVEWAYS TO MATCH EXISTING.
8) ALL ASPHALT AREAS TO BE RESTORED TO MATCH EXISTING.
9) RESTORE ALL OPEN DRAINS TO MATCH ORIGINAL GRADE AND CONTOUR CONDITIONS.
10) ALL WORK MUST BE IN ACCORDANCE WITH THE UNION GAS CONSTRUCTION AND MAINTENANCE MANUAL SPECIFICATIONS.
11) ALL WELDS TO BE NON-DESTRUCTIVELY EXAMINED, AS PER C&M 3.6.8.

DESIGN PARAMETERS

DESIGN

- DESIGNED TO CSA Z662-15
- DESIGN FACTOR - 0.8
- LOCATION FACTOR - **
- DESIGN TEMPERATURE - MSC
- DESIGN PRESSURE - 6040 kPa

TEST PRESSURE

- MINIMUM - ****kPa
- MAXIMUM - ****kPa
- TEST DATE:_____

ENGINEER:

PRELIMINARY

12.5 0 25 50 75 METRES
25 0 25 50 75 100 125 250 FEET

No.	DATE	BY	APPD	REMARKS
A	2018-01-12	N.C.	D.T.L.	O.E.B. FILING

REVISIONS

uniongas
An Enbridge Company

NPS 20 KINGSVILLE TRANSMISSION REINFORCEMENT PROJECT
2019 CONSTRUCTION - TOWN OF KINGSVILLE
GENERAL LOCATIONS - OEB FILING

DRAWN BY: MATT WADDICK	DATE: 2017-11-22	PLOT SPEC:	1:2000
CHECKED BY:	DATE:	CAD CODE:	PL1876-OEB-15.dgn
APPROVED BY:	DATE:	FILE REVISION DATE:	2018-01-12
SIZE: STRIP	SHEET: N/A	DRAWING No.:	PL1876-OEB-15

TOWN OF KINGSVILLE
COUNTY OF ESSEX

LEGEND
CONSTRUCTION NOTES:
DESIGN PARAMETERS
PRELIMINARY

12.5 0 25 50 75 METRES
25 0 25 50 75 100 125 250 FEET

No.	DATE	BY	APPD	REMARKS
B	2018-12-07	M.W.	D.T.L.	O.E.B. FILING 2
A	2018-01-12	N.C.	D.T.L.	O.E.B. FILING

REVISIONS
uniongas
An Enbridge Company
NPS 20 KINGSVILLE TRANSMISSION REINFORCEMENT PROJECT
2019 CONSTRUCTION - TOWN OF KINGSVILLE
GENERAL LOCATIONS - OEB FILING

DRAWN BY: MATT WADDICK	DATE: 2017-11-22	PLOT SPEC:	1:2000
CHECKED BY:	DATE:	CAD CODE:	PL1876-OEB-15.dgn
APPROVED BY:	DATE:	FILE REVISION DATE:	2018-12-07
SIZE: STRIP	SHEET: N/A	DRAWING No.:	PL1876-OEB-15

Filed: 2018-12-19
EB-2018-0013
Schedule 1
Change Request
Page 15 of 18
Redacted

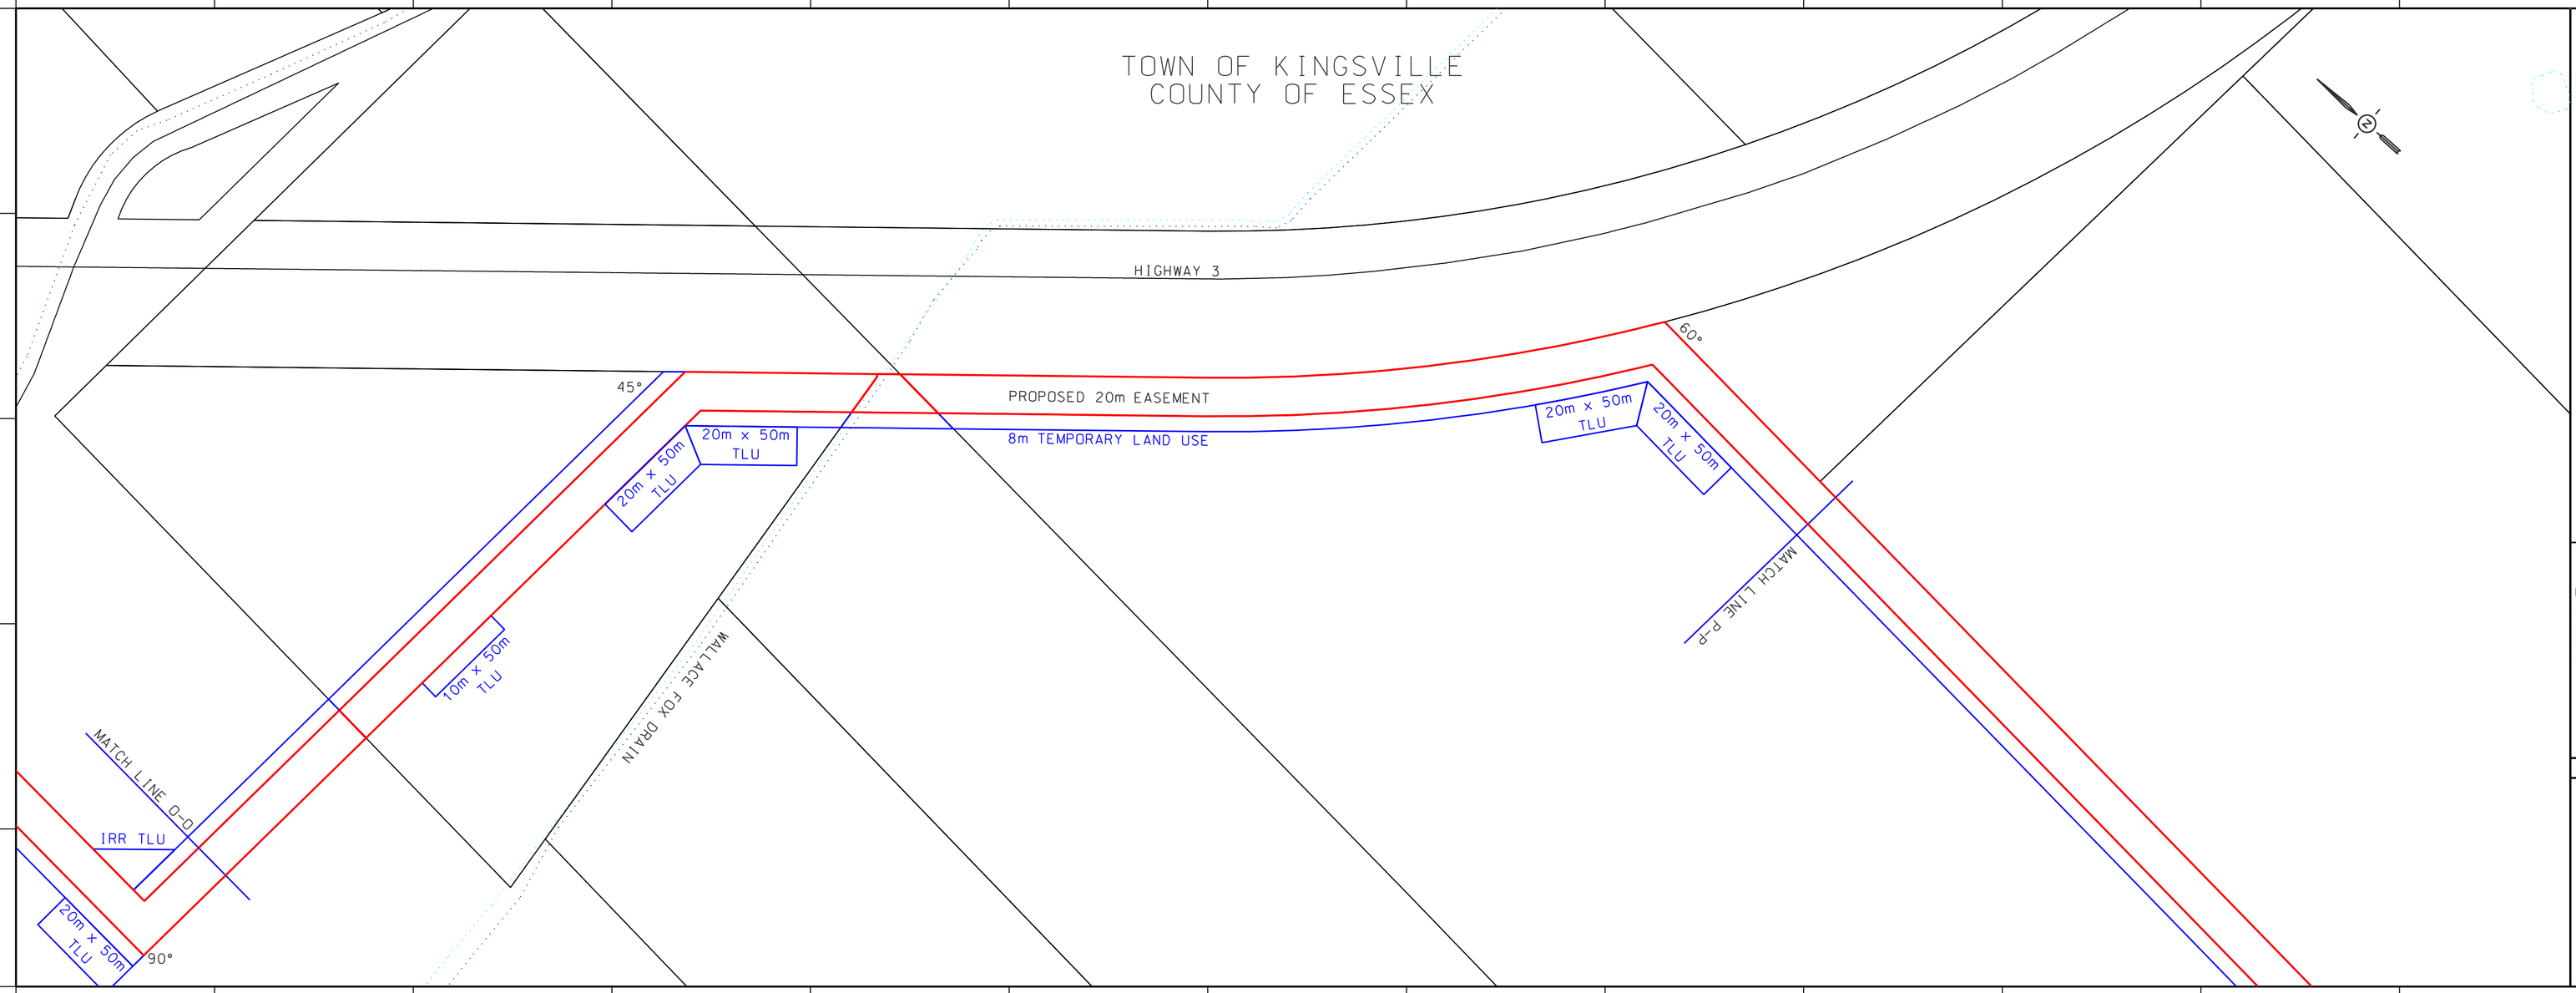

LEGEND

- PROPOSED PIPELINE
- PROPOSED PIPELINE EASEMENT
- TEMPORARY LAND USE
- TEMPORARY LAND USE (NO IMAGERY)
- NEW TEMPORARY LAND USE
- EXISTING PIPELINE EASEMENT
- MOZ AREAS
- WATERCOURSE

CONSTRUCTION NOTES:

1) CONTRACTOR RESPONSIBLE FOR ALL UTILITY LOCATES.
2) DEPTH OF MAIN TO BE 1.2m BELOW ℄ OF ROAD OR DITCH. WHICHEVER IS LOWER.
3) MINIMUM DEPTH OF COVER 1.2m. 1.5m FOR ALL ROAD AND CREEK CROSSINGS AND 3.25m FOR RAILWAY CROSSINGS.
4) MAINTAIN MIN. 500mm CLEARANCE BETWEEN PROPOSED MAIN AND OTHER UTILITIES AND UNDERGROUND STRUCTURES THAT ARE CROSSED.
5) ALL CULVERTS, END WALL TREATMENT AND TILE DRAINS REMOVED DURING CONSTRUCTION ARE TO BE RESTORED TO MATCH EXISTING CONDITIONS.
6) RESTORATION INCLUDES TOPSOIL AND SEEDING.
7) RESTORE DRIVEWAYS TO MATCH EXISTING.
8) ALL ASPHALT AREAS TO BE RESTORED TO MATCH EXISTING.
9) RESTORE ALL OPEN DRAINS TO MATCH ORIGINAL GRADE AND CONTOUR CONDITIONS.
10) ALL WORK MUST BE IN ACCORDANCE WITH THE UNION GAS CONSTRUCTION AND MAINTENANCE MANUAL SPECIFICATIONS.
11) ALL WELDS TO BE NON-DESTRUCTIVELY EXAMINED, AS PER C&M 3.6.8.

DESIGN PARAMETERS

DESIGN

- DESIGNED TO CSA Z662-15
- DESIGN FACTOR - 0.8
- LOCATION FACTOR - **
- DESIGN TEMPERATURE - MSC
- DESIGN PRESSURE - 6040 kPa

TEST PRESSURE

- MINIMUM - ****kPa
- MAXIMUM - ****kPa
- TEST DATE:_____

ENGINEER:

PRELIMINARY

12.5 0 25 50 75 METRES
25 0 25 50 75 100 125 250 FEET

No.	DATE	BY	APPD	REMARKS
A	2018-01-12	N.C.	D.T.L.	OEB FILING
B	2018-12-07	M.W.	D.T.L.	OEB FILING 2

REVISIONS

uniongas
An Enbridge Company

NPS 20 KINGSVILLE TRANSMISSION REINFORCEMENT PROJECT
2019 CONSTRUCTION - TOWN OF KINGSVILLE
GENERAL LOCATIONS - OEB FILING

DRAWN BY: MATT WADDICK	DATE: 2017-11-22	PLOT SPEC:	1:2000
CHECKED BY:	DATE:	CAD CODE:	PL1876-OEB-16.dgn
APPROVED BY:	DATE:	FILE REVISION DATE:	2018-01-12
SIZE: STRIP	SHEET: N/A	DRAWING No.:	PL1876-OEB-16

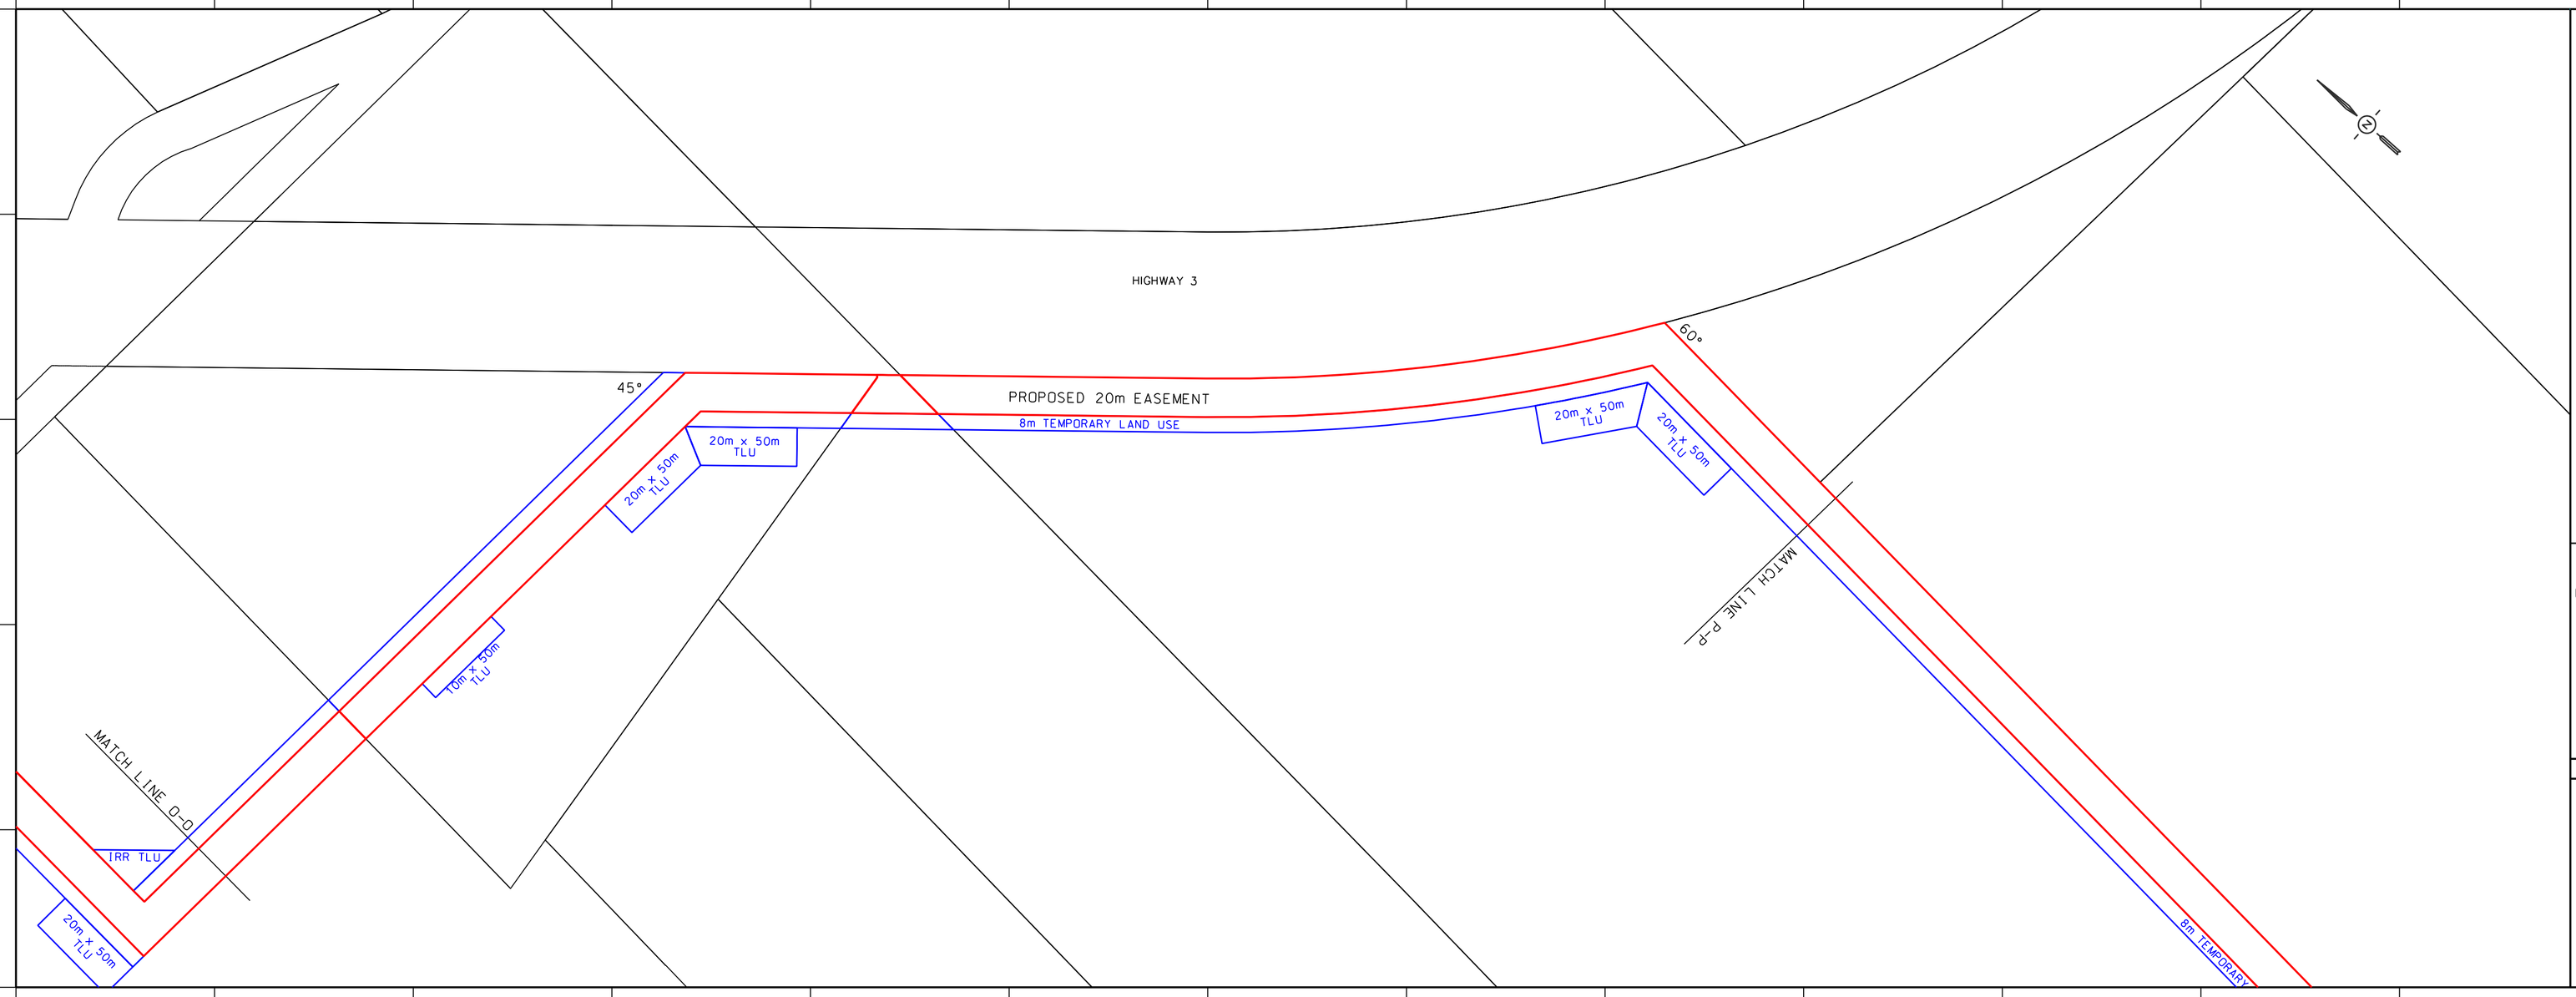

LEGEND

- PROPOSED PIPELINE
- PROPOSED PIPELINE EASEMENT
- TEMPORARY LAND USE
- TEMPORARY LAND USE (NO IMAGERY)
- NEW TEMPORARY LAND USE
- EXISTING PIPELINE EASEMENT
- MOZ AREAS
- WATERCOURSE

CONSTRUCTION NOTES:

1) CONTRACTOR RESPONSIBLE FOR ALL UTILITY LOCATES.
2) DEPTH OF MAIN TO BE 1.2m BELOW ℄ OF ROAD OR DITCH. WHICHEVER IS LOWER.
3) MINIMUM DEPTH OF COVER 1.2m. 1.5m FOR ALL ROAD AND CREEK CROSSINGS AND 3.25m FOR RAILWAY CROSSINGS.
4) MAINTAIN MIN. 500mm CLEARANCE BETWEEN PROPOSED MAIN AND OTHER UTILITIES AND UNDERGROUND STRUCTURES THAT ARE CROSSED.
5) ALL CULVERTS, END WALL TREATMENT AND TILE DRAINS REMOVED DURING CONSTRUCTION ARE TO BE RESTORED TO MATCH EXISTING CONDITIONS.
6) RESTORATION INCLUDES TOPSOIL AND SEEDING.
7) RESTORE DRIVEWAYS TO MATCH EXISTING.
8) ALL ASPHALT AREAS TO BE RESTORED TO MATCH EXISTING.
9) RESTORE ALL OPEN DRAINS TO MATCH ORIGINAL GRADE AND CONTOUR CONDITIONS.
10) ALL WORK MUST BE IN ACCORDANCE WITH THE UNION GAS CONSTRUCTION AND MAINTENANCE MANUAL SPECIFICATIONS.
11) ALL WELDS TO BE NON-DESTRUCTIVELY EXAMINED, AS PER C&M 3.6.8.

DESIGN PARAMETERS

DESIGN

- DESIGNED TO CSA Z662-15
- DESIGN FACTOR - 0.8
- LOCATION FACTOR - **
- DESIGN TEMPERATURE - MSC
- DESIGN PRESSURE - 6040 kPa

TEST PRESSURE

- MINIMUM - ****kPa
- MAXIMUM - ****kPa
- TEST DATE:_____

ENGINEER:

PRELIMINARY

12.5 0 25 50 75 METRES
25 0 25 50 75 100 125 250 FEET

No.	DATE	BY	APPD	REMARKS
A	2018-01-12	N.C.	D.T.L.	OEB FILING
B	2018-12-07	M.W.	D.T.L.	OEB FILING 2

REVISIONS

uniongas
An Enbridge Company

NPS 20 KINGSVILLE TRANSMISSION REINFORCEMENT PROJECT
2019 CONSTRUCTION - TOWN OF KINGSVILLE
GENERAL LOCATIONS - OEB FILING

DRAWN BY: MATT WADDICK	DATE: 2017-11-22	PLOT SPEC:	1:2000
CHECKED BY:	DATE:	CAD CODE:	PL1876-OEB-16.dgn
APPROVED BY:	DATE:	FILE REVISION DATE:	2018-12-07
SIZE: STRIP	SHEET: N/A	DRAWING No.:	PL1876-OEB-16

Filed: 2018-12-19
EB-2018-0013
Schedule 1
Change Request
Page 16 of 18

Filed: 2018-12-19
EB-2018-0013
Exhibit I
Tab 1
Schedule 1
Page 17 of 18
Attachment 1
Plan and Profile Drawing

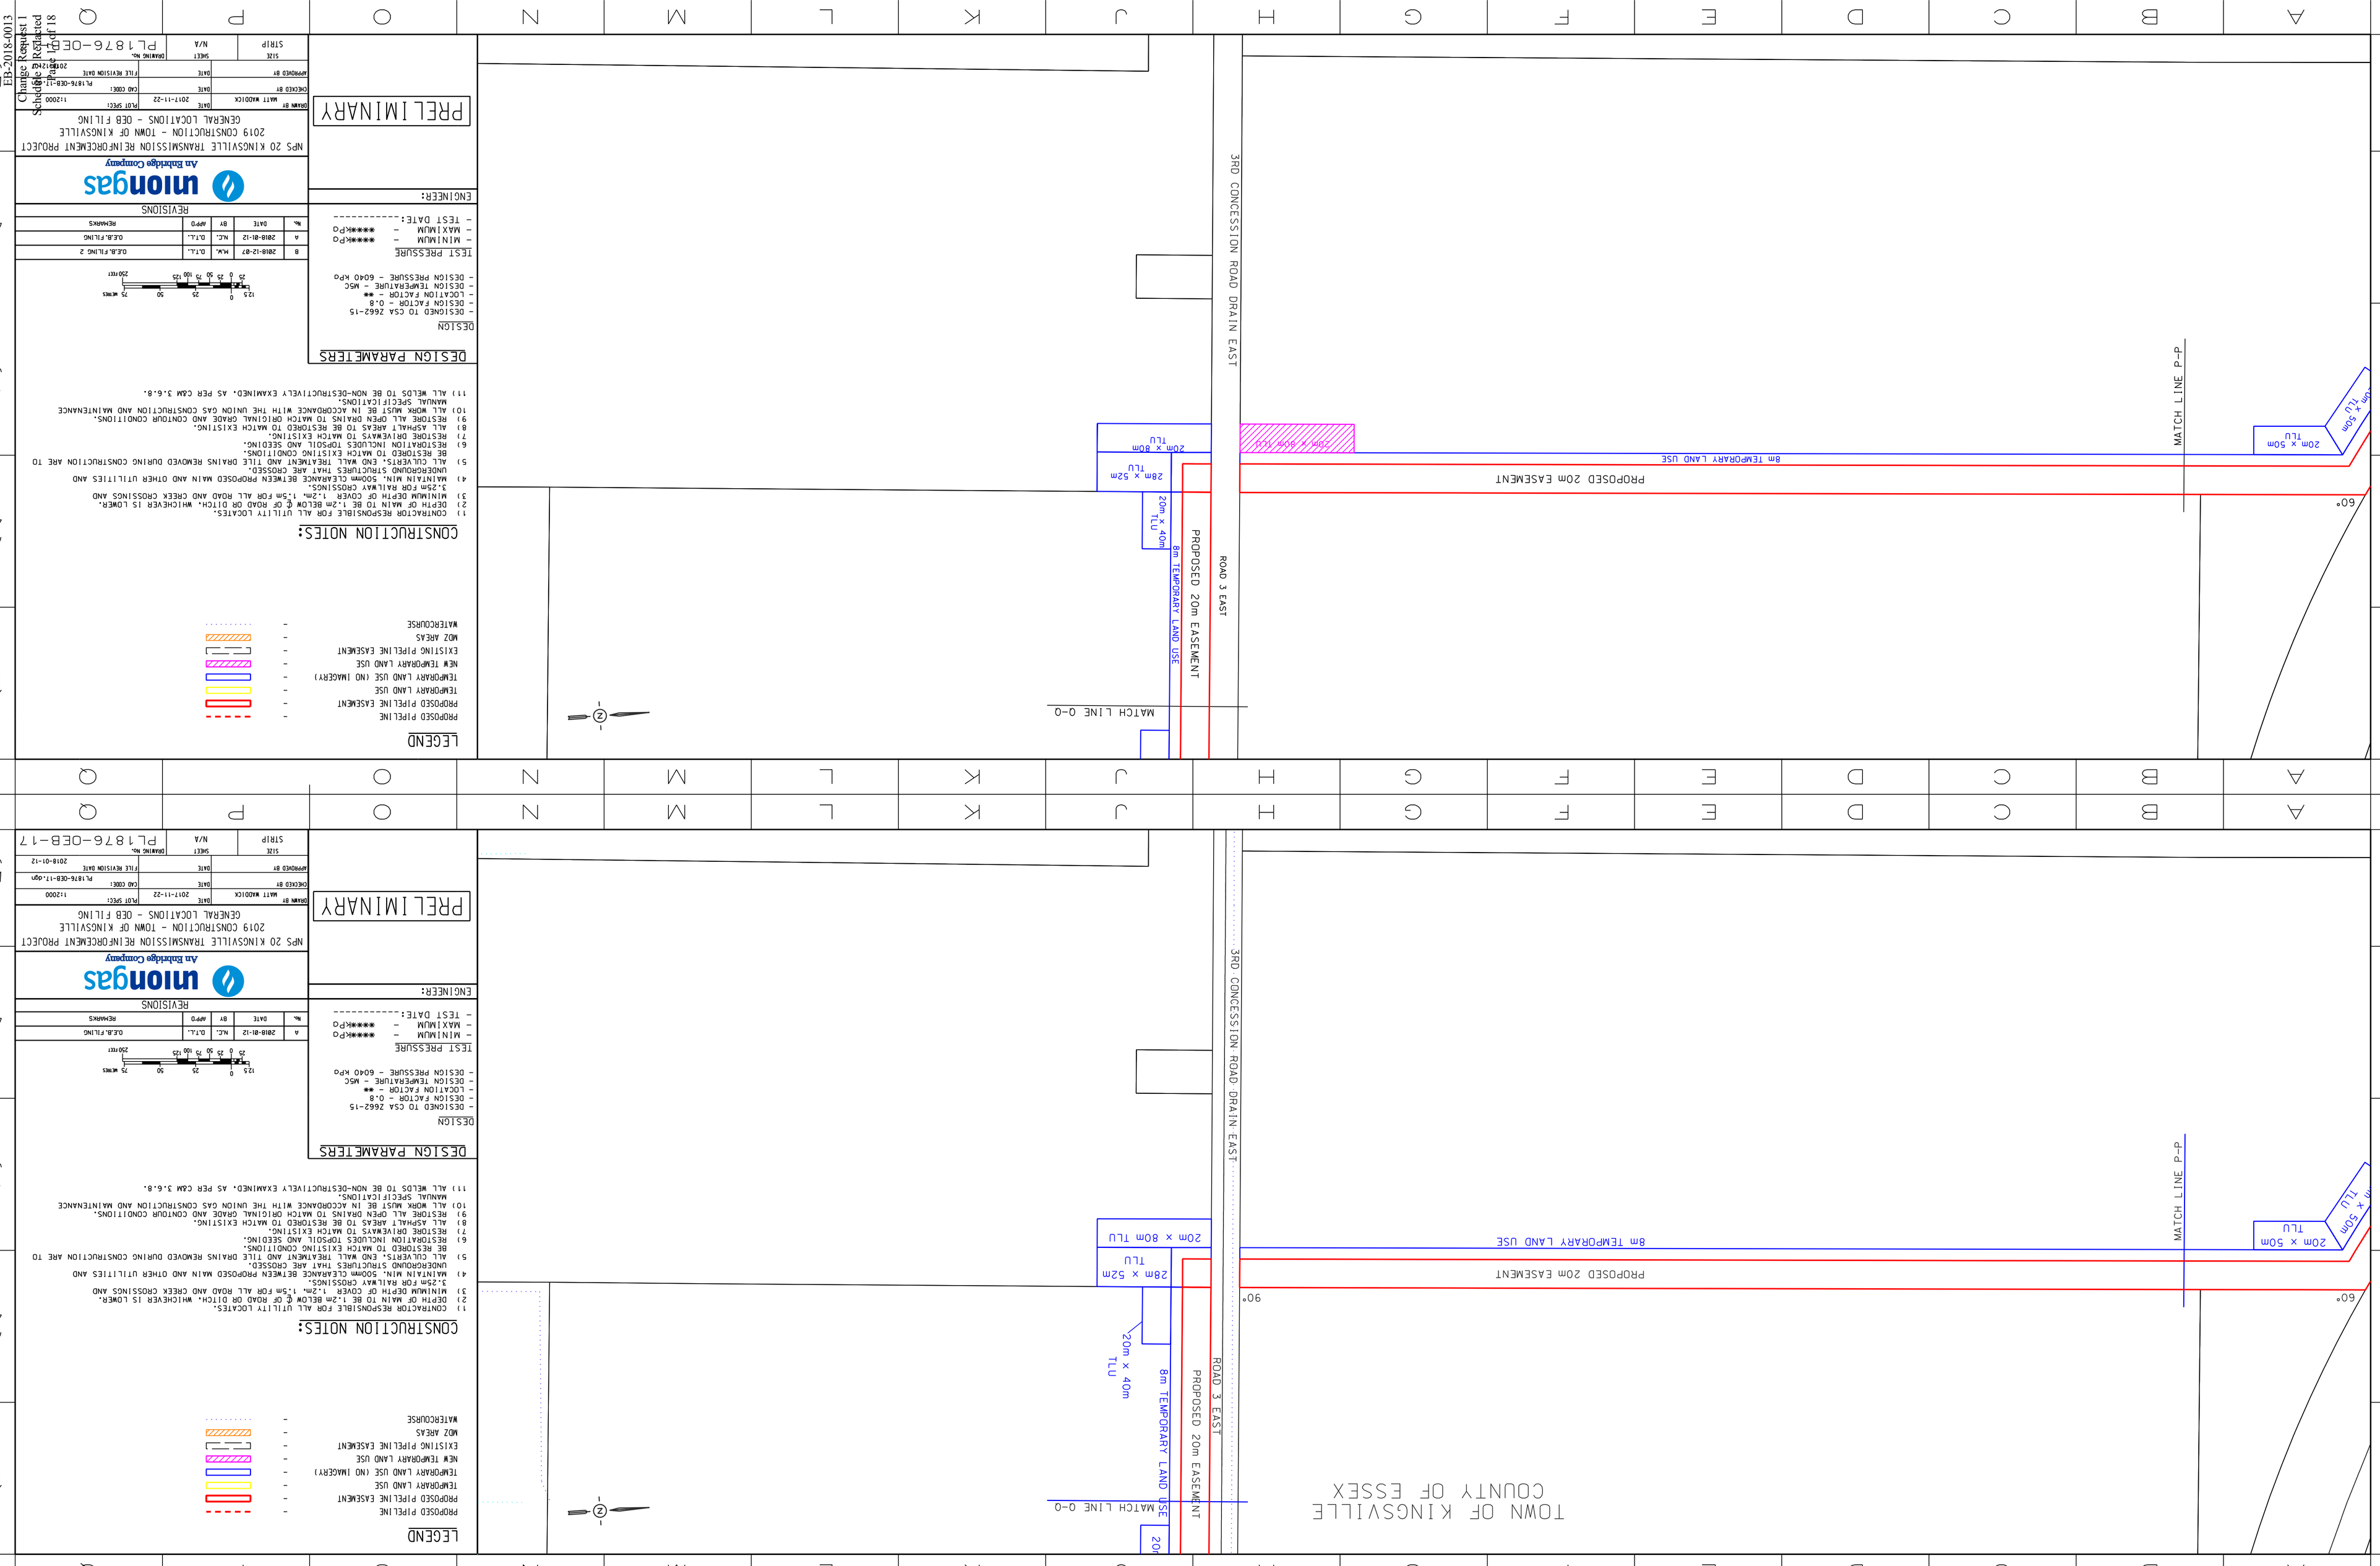

PRELIMINARY

NPS 20 KINGSVILLE TRANSMISSION REINFORCEMENT PROJECT
2019 CONSTRUCTION - TOWN OF KINGSVILLE
GENERAL LOCATIONS - OEB FILING

DRAWN BY	DATE	2017-11-22	MQT SPEC:	1:2000
CHECKED BY	DATE		CAD CODE:	PL1876-OEB-17.dgn
APPROVED BY	DATE		FILE REVISION DATE	2018-01-12
SIZE	SHEET		DRAWING No.	
STRIP	N/A			PL1876-OEB-17

union gas
An Enbridge Company

REVISIONS

No.	DATE	BY	APP'D	REMARKS
A	2018-01-12	M.C.	D.T.L.	O.E.B. FILING
B	2018-12-07	M.M.	D.T.L.	O.E.B. FILING 2

0 25 50 75 100 125 METRES
0 25 50 75 100 125 250 FEET

ENGINEER:

TEST PRESSURE
- MINIMUM - ****kPa
- MAXIMUM - ****kPa
- TEST DATE: ----------

DESIGN
- DESIGNED TO CSA Z662-15
- DESIGN FACTOR - 0.8
- LOCATION FACTOR - **
- DESIGN TEMPERATURE - MSC
- DESIGN PRESSURE - 6040 kPa

DESIGN PARAMETERS

CONSTRUCTION NOTES:
1) CONTRACTOR RESPONSIBLE FOR ALL UTILITY LOCATES.
2) DEPTH OF MAIN TO BE 1.2m BELOW ℄ OF ROAD OR DITCH. WHICHEVER IS LOWER.
3) MINIMUM DEPTH OF COVER 1.2m, 1.5m FOR ALL ROAD AND CREEK CROSSINGS AND 3.25m FOR RAILWAY CROSSINGS.
4) MAINTAIN MIN. 500mm CLEARANCE BETWEEN PROPOSED MAIN AND OTHER UTILITIES AND UNDERGROUND STRUCTURES THAT ARE CROSSED.
5) ALL CULVERTS, END WALL TREATMENT AND TILE DRAINS REMOVED DURING CONSTRUCTION ARE TO BE RESTORED TO MATCH EXISTING CONDITIONS.
6) RESTORATION INCLUDES TOPSOIL AND SEEDING.
7) RESTORE DRIVEWAYS TO MATCH EXISTING.
8) ALL ASPHALT AREAS TO BE RESTORED TO MATCH EXISTING.
9) RESTORE ALL OPEN DRAINS TO MATCH ORIGINAL GRADE AND CONTOUR CONDITIONS.
10) ALL WORK MUST BE IN ACCORDANCE WITH THE UNION GAS CONSTRUCTION AND MAINTENANCE MANUAL SPECIFICATIONS.
11) ALL WELDS TO BE NON-DESTRUCTIVELY EXAMINED. AS PER CSA 3.6.8.

LEGEND
- PROPOSED PIPELINE
- PROPOSED PIPELINE EASEMENT
- TEMPORARY LAND USE
- TEMPORARY LAND USE (NO IMAGERY)
- NEW TEMPORARY LAND USE
- EXISTING PIPELINE EASEMENT
- MOZ AREAS
- WATERCOURSE

PRELIMINARY

NPS 20 KINGSVILLE TRANSMISSION REINFORCEMENT PROJECT
2019 CONSTRUCTION - TOWN OF KINGSVILLE
GENERAL LOCATIONS - OEB FILING

union gas
An Enbridge Company

REVISIONS

ENGINEER:

TEST PRESSURE
- MINIMUM - ****kPa
- MAXIMUM - ****kPa
- TEST DATE: ----------

DESIGN
- DESIGNED TO CSA Z662-15
- DESIGN FACTOR - 0.8
- LOCATION FACTOR - **
- DESIGN TEMPERATURE - MSC
- DESIGN PRESSURE - 6040 kPa

DESIGN PARAMETERS

CONSTRUCTION NOTES:
1) CONTRACTOR RESPONSIBLE FOR ALL UTILITY LOCATES.
2) DEPTH OF MAIN TO BE 1.2m BELOW ℄ OF ROAD OR DITCH. WHICHEVER IS LOWER.
3) MINIMUM DEPTH OF COVER 1.2m, 1.5m FOR ALL ROAD AND CREEK CROSSINGS AND 3.25m FOR RAILWAY CROSSINGS.
4) MAINTAIN MIN. 500mm CLEARANCE BETWEEN PROPOSED MAIN AND OTHER UTILITIES AND UNDERGROUND STRUCTURES THAT ARE CROSSED.
5) ALL CULVERTS, END WALL TREATMENT AND TILE DRAINS REMOVED DURING CONSTRUCTION ARE TO BE RESTORED TO MATCH EXISTING CONDITIONS.
6) RESTORATION INCLUDES TOPSOIL AND SEEDING.
7) RESTORE DRIVEWAYS TO MATCH EXISTING.
8) ALL ASPHALT AREAS TO BE RESTORED TO MATCH EXISTING.
9) RESTORE ALL OPEN DRAINS TO MATCH ORIGINAL GRADE AND CONTOUR CONDITIONS.
10) ALL WORK MUST BE IN ACCORDANCE WITH THE UNION GAS CONSTRUCTION AND MAINTENANCE MANUAL SPECIFICATIONS.
11) ALL WELDS TO BE NON-DESTRUCTIVELY EXAMINED. AS PER CSA 3.6.8.

LEGEND
- PROPOSED PIPELINE
- PROPOSED PIPELINE EASEMENT
- TEMPORARY LAND USE
- TEMPORARY LAND USE (NO IMAGERY)
- NEW TEMPORARY LAND USE
- EXISTING PIPELINE EASEMENT
- MOZ AREAS
- WATERCOURSE

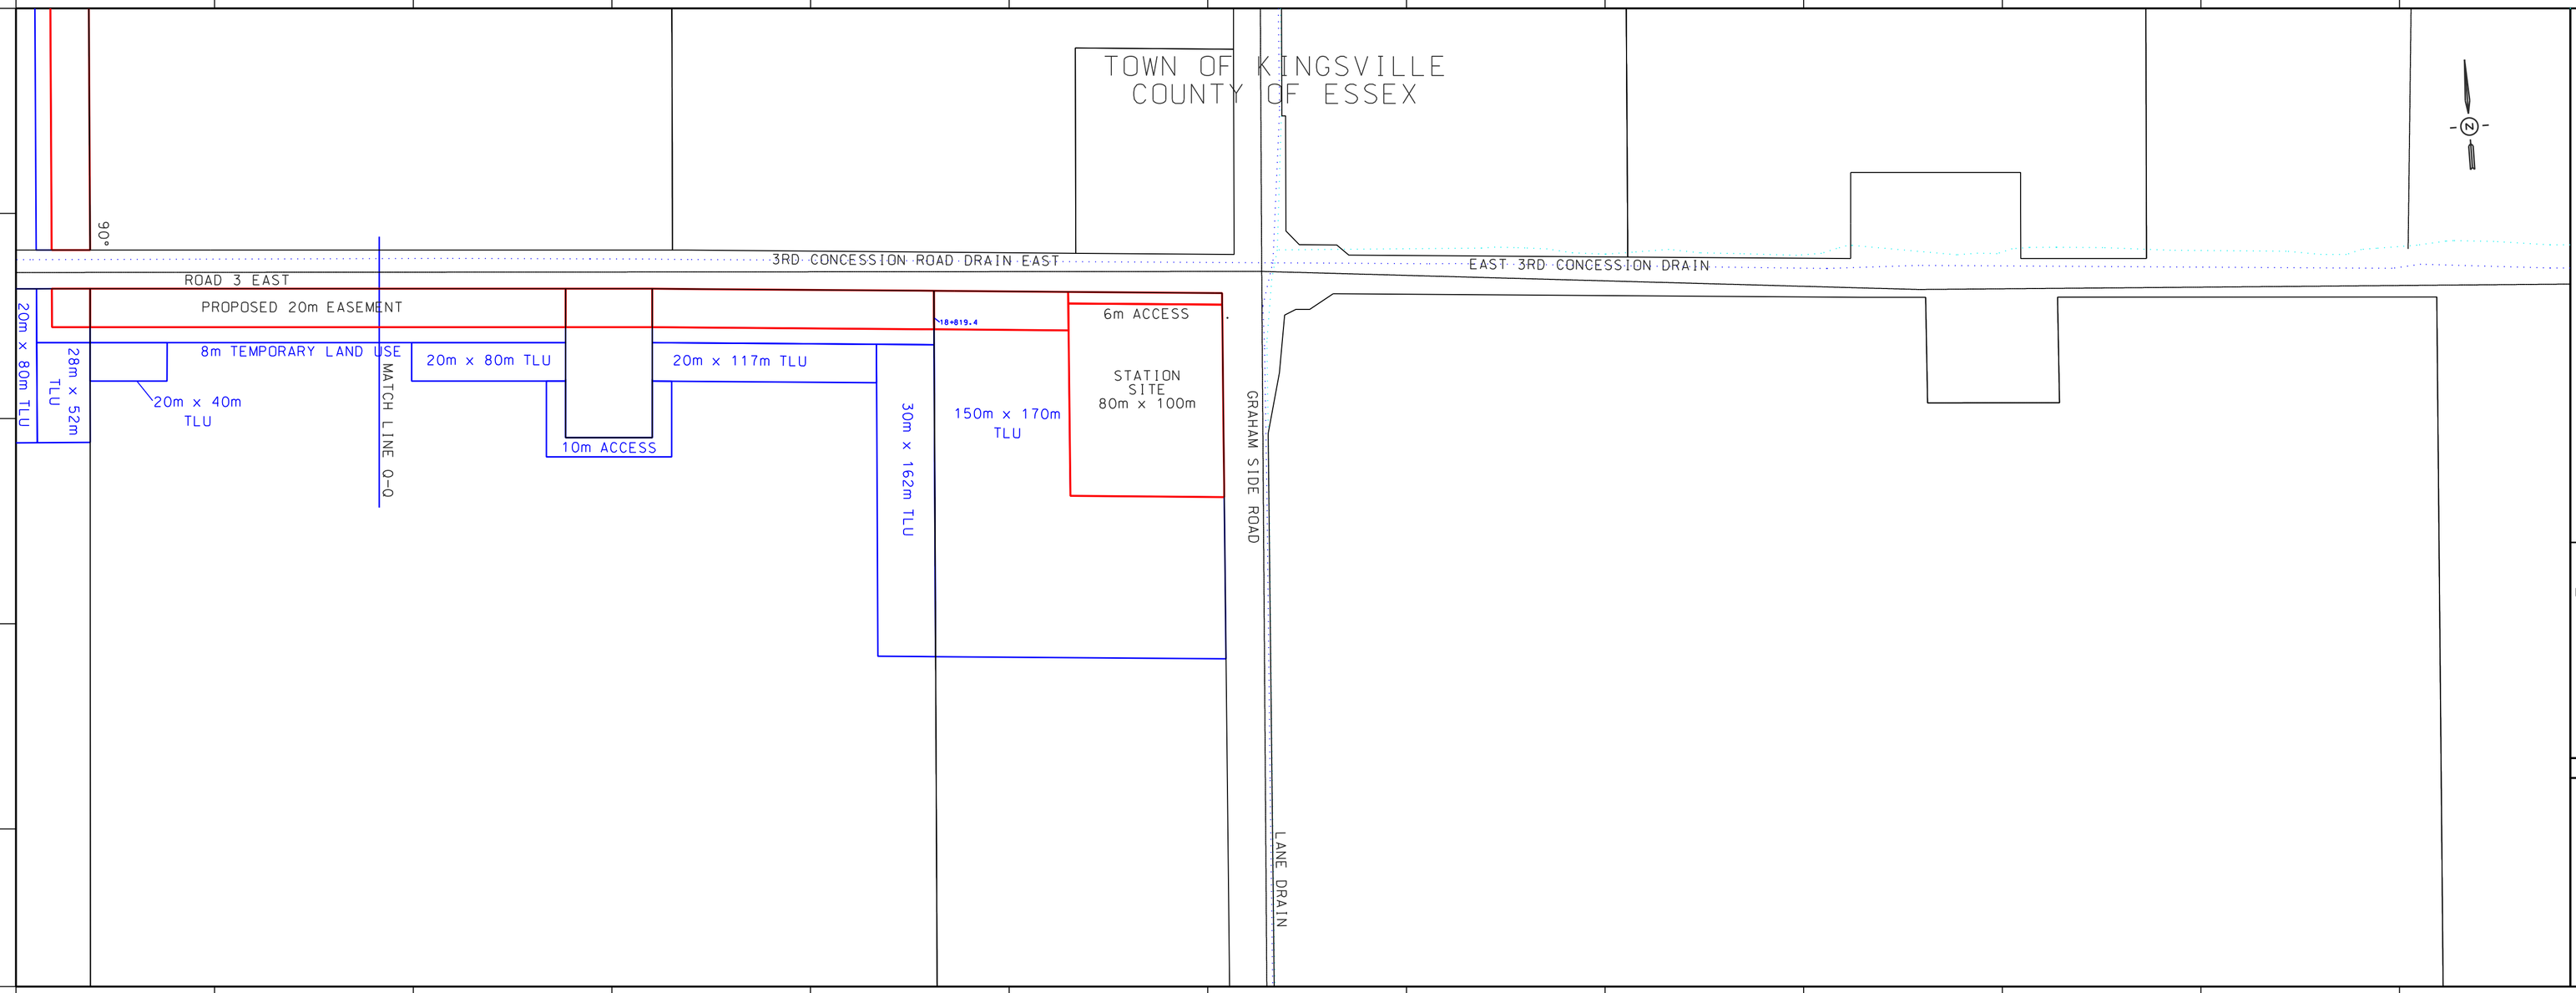

LEGEND

- PROPOSED PIPELINE
- PROPOSED PIPELINE EASEMENT
- TEMPORARY LAND USE
- TEMPORARY LAND USE (NO IMAGERY)
- NEW TEMPORARY LAND USE
- EXISTING PIPELINE EASEMENT
- MOZ AREAS
- WATERCOURSE

CONSTRUCTION NOTES:

1) CONTRACTOR RESPONSIBLE FOR ALL UTILITY LOCATES.
2) DEPTH OF MAIN TO BE 1.2m BELOW ℄ OF ROAD OR DITCH. WHICHEVER IS LOWER.
3) MINIMUM DEPTH OF COVER 1.2m. 1.5m FOR ALL ROAD AND CREEK CROSSINGS AND 3.25m FOR RAILWAY CROSSINGS.
4) MAINTAIN MIN. 500mm CLEARANCE BETWEEN PROPOSED MAIN AND OTHER UTILITIES AND UNDERGROUND STRUCTURES THAT ARE CROSSED.
5) ALL CULVERTS, END WALL TREATMENT AND TILE DRAINS REMOVED DURING CONSTRUCTION ARE TO BE RESTORED TO MATCH EXISTING CONDITIONS.
6) RESTORATION INCLUDES TOPSOIL AND SEEDING.
7) RESTORE DRIVEWAYS TO MATCH EXISTING.
8) ALL ASPHALT AREAS TO BE RESTORED TO MATCH EXISTING.
9) RESTORE ALL OPEN DRAINS TO MATCH ORIGINAL GRADE AND CONTOUR CONDITIONS.
10) ALL WORK MUST BE IN ACCORDANCE WITH THE UNION GAS CONSTRUCTION AND MAINTENANCE MANUAL SPECIFICATIONS.
11) ALL WELDS TO BE NON-DESTRUCTIVELY EXAMINED, AS PER C&M 3.6.8.

DESIGN PARAMETERS

DESIGN

- DESIGNED TO CSA Z662-15
- DESIGN FACTOR - 0.8
- LOCATION FACTOR - **
- DESIGN TEMPERATURE - MSC
- DESIGN PRESSURE - 6040 kPa

TEST PRESSURE

- MINIMUM - ****kPa
- MAXIMUM - ****kPa
- TEST DATE:_____

ENGINEER:

PRELIMINARY

12.5 0 25 50 75 METRES
25 0 25 50 75 100 125 250 FEET

No.	DATE	BY	APPD	REMARKS
A	2018-01-12	N.C.	D.T.L.	O.E.B. FILING

REVISIONS

uniongas
An Enbridge Company

NPS 20 KINGSVILLE TRANSMISSION REINFORCEMENT PROJECT
2019 CONSTRUCTION - TOWN OF KINGSVILLE
GENERAL LOCATIONS - OEB FILING

DRAWN BY: MATT WADDICK	DATE: 2017-11-22	PLOT SPEC:	1:2000
CHECKED BY:	DATE:	CAD CODE:	PL1876-OEB-18.dgn
APPROVED BY:	DATE:	FILE REVISION DATE:	2018-01-12
SIZE: STRIP	SHEET: N/A	DRAWING No.:	PL1876-OEB-18

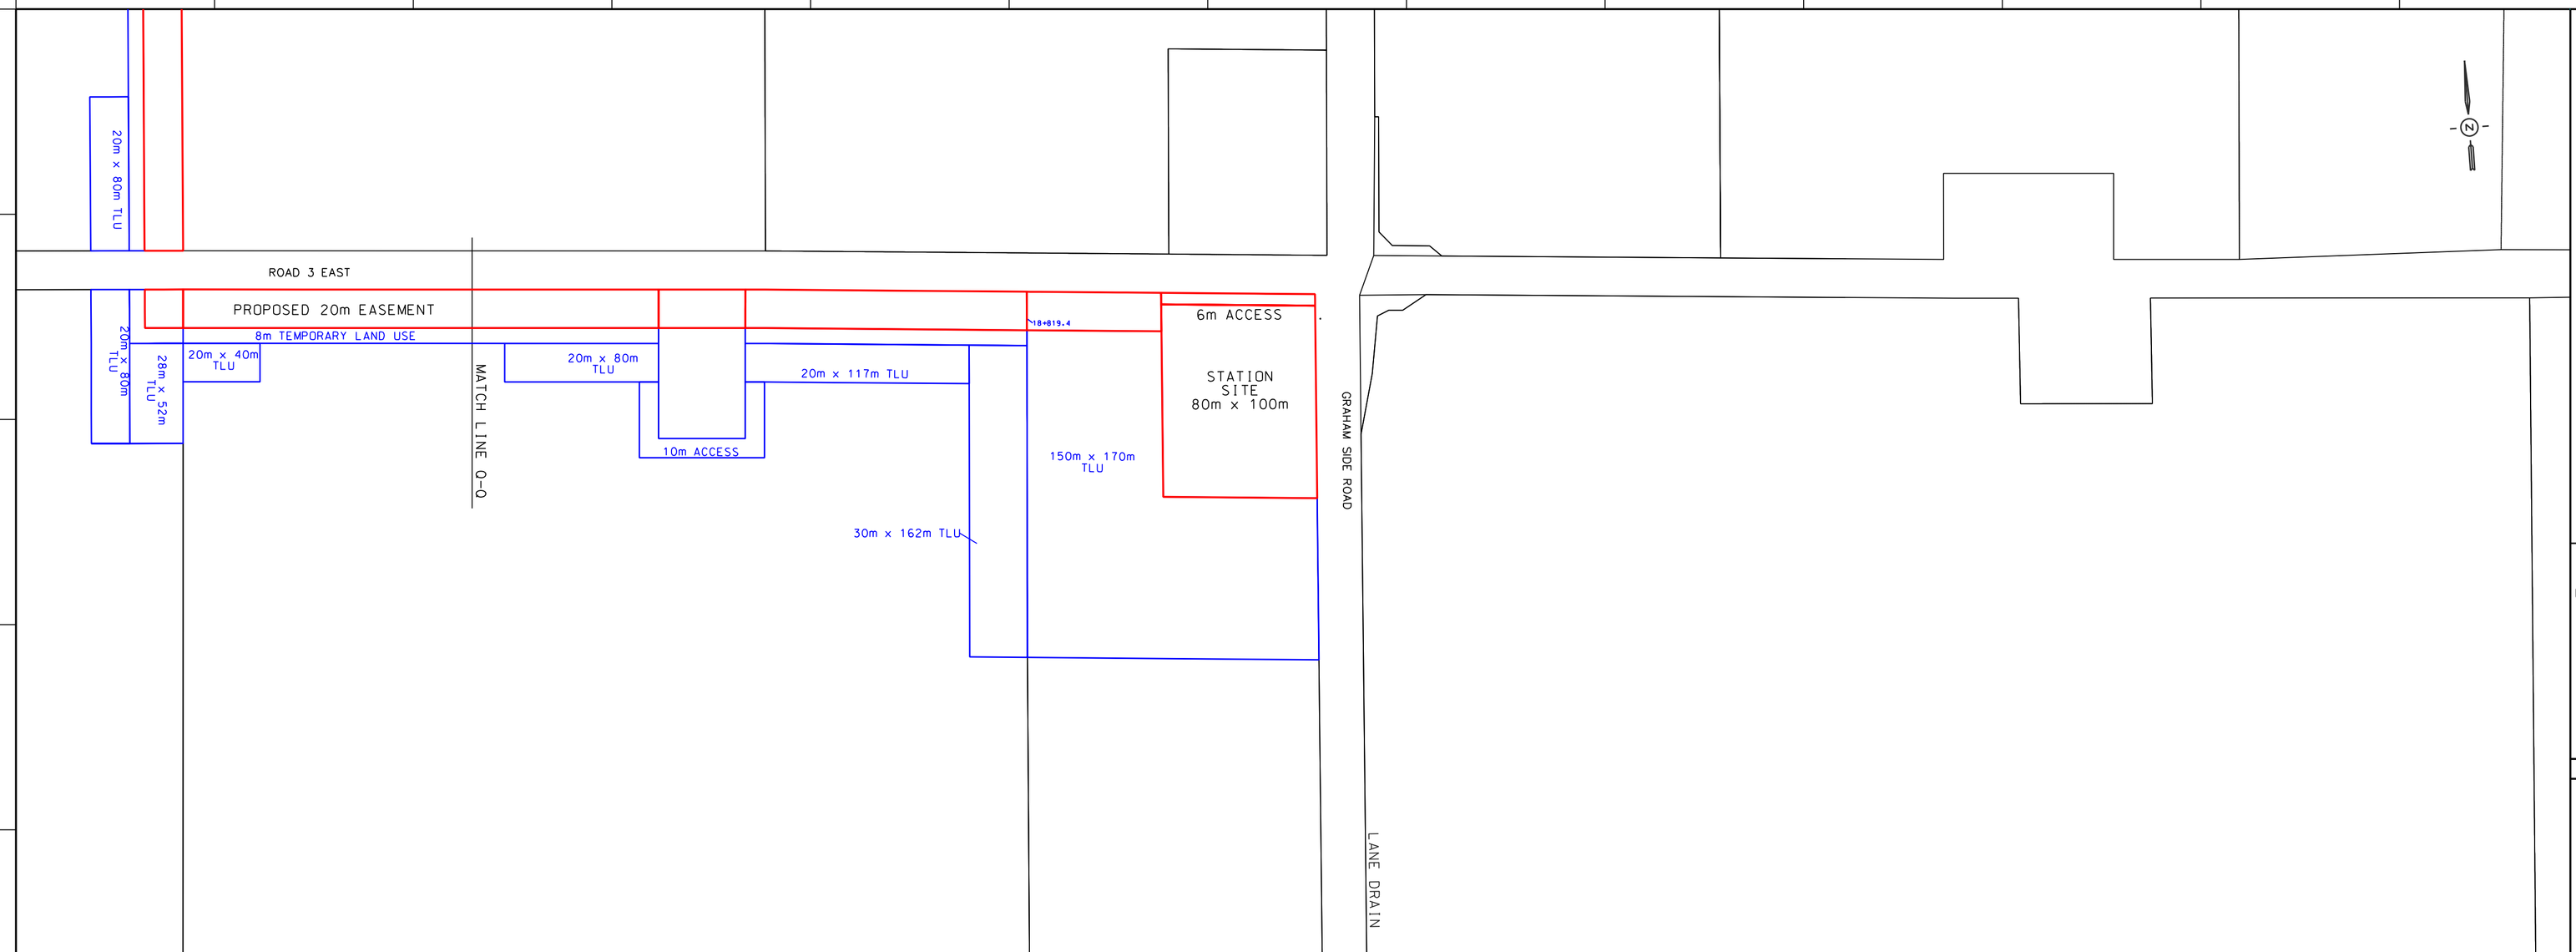

LEGEND

- PROPOSED PIPELINE
- PROPOSED PIPELINE EASEMENT
- TEMPORARY LAND USE
- TEMPORARY LAND USE (NO IMAGERY)
- NEW TEMPORARY LAND USE
- EXISTING PIPELINE EASEMENT
- MOZ AREAS
- WATERCOURSE

CONSTRUCTION NOTES:

1) CONTRACTOR RESPONSIBLE FOR ALL UTILITY LOCATES.
2) DEPTH OF MAIN TO BE 1.2m BELOW ℄ OF ROAD OR DITCH. WHICHEVER IS LOWER.
3) MINIMUM DEPTH OF COVER 1.2m. 1.5m FOR ALL ROAD AND CREEK CROSSINGS AND 3.25m FOR RAILWAY CROSSINGS.
4) MAINTAIN MIN. 500mm CLEARANCE BETWEEN PROPOSED MAIN AND OTHER UTILITIES AND UNDERGROUND STRUCTURES THAT ARE CROSSED.
5) ALL CULVERTS, END WALL TREATMENT AND TILE DRAINS REMOVED DURING CONSTRUCTION ARE TO BE RESTORED TO MATCH EXISTING CONDITIONS.
6) RESTORATION INCLUDES TOPSOIL AND SEEDING.
7) RESTORE DRIVEWAYS TO MATCH EXISTING.
8) ALL ASPHALT AREAS TO BE RESTORED TO MATCH EXISTING.
9) RESTORE ALL OPEN DRAINS TO MATCH ORIGINAL GRADE AND CONTOUR CONDITIONS.
10) ALL WORK MUST BE IN ACCORDANCE WITH THE UNION GAS CONSTRUCTION AND MAINTENANCE MANUAL SPECIFICATIONS.
11) ALL WELDS TO BE NON-DESTRUCTIVELY EXAMINED, AS PER C&M 3.6.8.

DESIGN PARAMETERS

DESIGN

- DESIGNED TO CSA Z662-15
- DESIGN FACTOR - 0.8
- LOCATION FACTOR - **
- DESIGN TEMPERATURE - MSC
- DESIGN PRESSURE - 6040 kPa

TEST PRESSURE

- MINIMUM - ****kPa
- MAXIMUM - ****kPa
- TEST DATE:_____

ENGINEER:

PRELIMINARY

12.5 0 25 50 75 METRES
25 0 25 50 75 100 125 250 FEET

No.	DATE	BY	APPD	REMARKS
B	2018-12-07	M.W.	D.T.L.	O.E.B. FILING 2
A	2018-01-12	N.C.	D.T.L.	O.E.B. FILING

REVISIONS

uniongas
An Enbridge Company

NPS 20 KINGSVILLE TRANSMISSION REINFORCEMENT PROJECT
2019 CONSTRUCTION - TOWN OF KINGSVILLE
GENERAL LOCATIONS - OEB FILING

DRAWN BY: MATT WADDICK	DATE: 2017-11-22	PLOT SPEC:	1:2000
CHECKED BY:	DATE:	CAD CODE:	PL1876-OEB-18.dgn
APPROVED BY:	DATE:	FILE REVISION DATE:	2018-12-07
SIZE: STRIP	SHEET: N/A	DRAWING No.:	PL1876-OEB-18

Filed: 2018-12-19
EB-2018-0013
Schedule 1
Change Request
Page 3 of 18
Redacted